

T. 8 S. R. 4 W. W.M.

FINAL PROOF SURVEY

Application G-14278 Permit G-13224


Dave Setniker

SCALE: 4" = 1 MI.


LOCATION OF ALL POINTS OF DIVERSION ARE FROM THE 'MOST E'LY. NE COR. OF THOMAS L. BURBANK DLC NO. 43.

- Well #1: 160' S & 4250' W
- Well #2: 990' S & 2575' W
- Well #3: 160' S & 1375' W
- Well #4: 410' S & 1060' W
- Well #5: 1920' S & 1930' E
- Well #6: 1390' S & 3550' E
- Well #7: 1100' S & 250' E
- Well #8: 1000' N & 2350' E

LEGEND

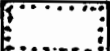-  SUPPLEMENTAL (465⁴ ac.)
-  GR 247 (407.7 ac.) (Wells 1-6)
-  C- 15133 (WILLAMETTE RIVER) (53.6 ac.)
-  C- 26530 (32.6 ac.) (Well no. 7)

NOTE: THE SECTION, DLC, AND PROPERTY LINES ARE LAID OUT IN AGREEMENT WITH THE POLK COUNTY ASSESSORS MAPS BASED ON THE LEGAL DESCRIPTIONS OF THE PROPERTIES INCLUDED HEREIN AND REPRESENT THE RELATIVE LOCATIONS OF ALL POINTS OF DIVERSION, EXISTING WATER RIGHTS AND THE AREA OF PRIMARY IRRIGATION.

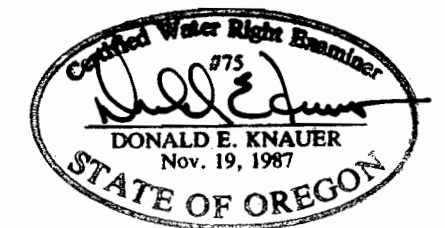

This map is for water right purposes only.