


TOWNSHIP 14 SOUTH, RANGE 12 EAST, W.M.  
Deschutes County

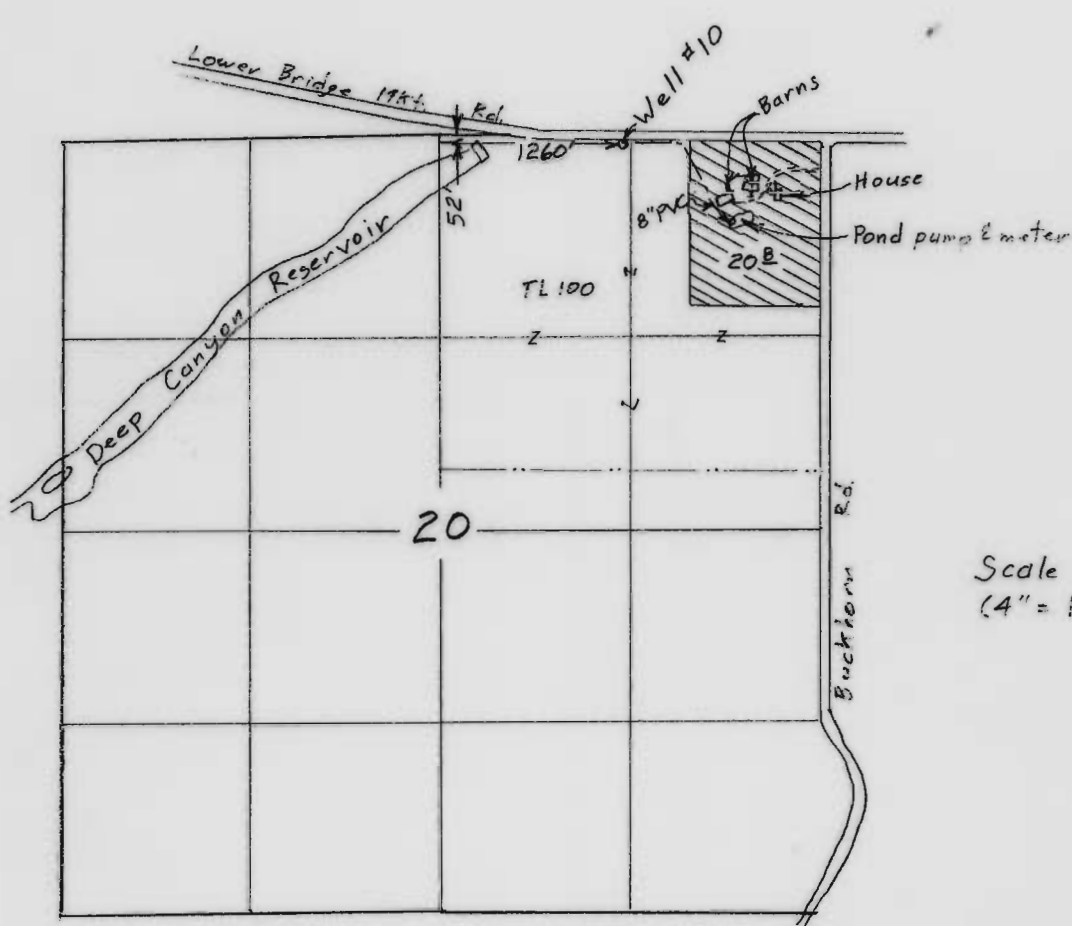

Scale 1" = 1320'  
(4" = 1 mile)

Surveyed August 25, 2004


**RECEIVED**

MAR 06 2006

WATER RESOURCES DEPT  
SALEM, OREGON

Claim of Beneficial Use Map  
for  
CRESCENT MOON RANCH

Application G-14358  
Permit G-13225

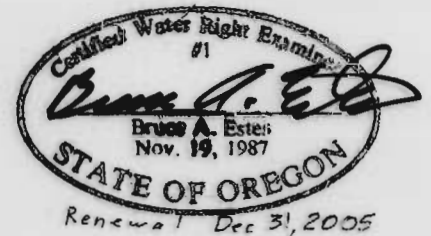

This map is for the purpose of  
locating a water right only  
and has no intent to provide  
legal dimensions or the location  
of property lines.

**ESTES SURVEYS**

PO Box 17519  
Salem, OR 97306-7519  
(503) 585-7593

60382 Arnold Rd  
Bend, OR 97702  
(541) 382-7391