


Claim of Beneficial Use




Permit No. G-13230

Application No. G-14290

In the name of Johann & Kay Teufl

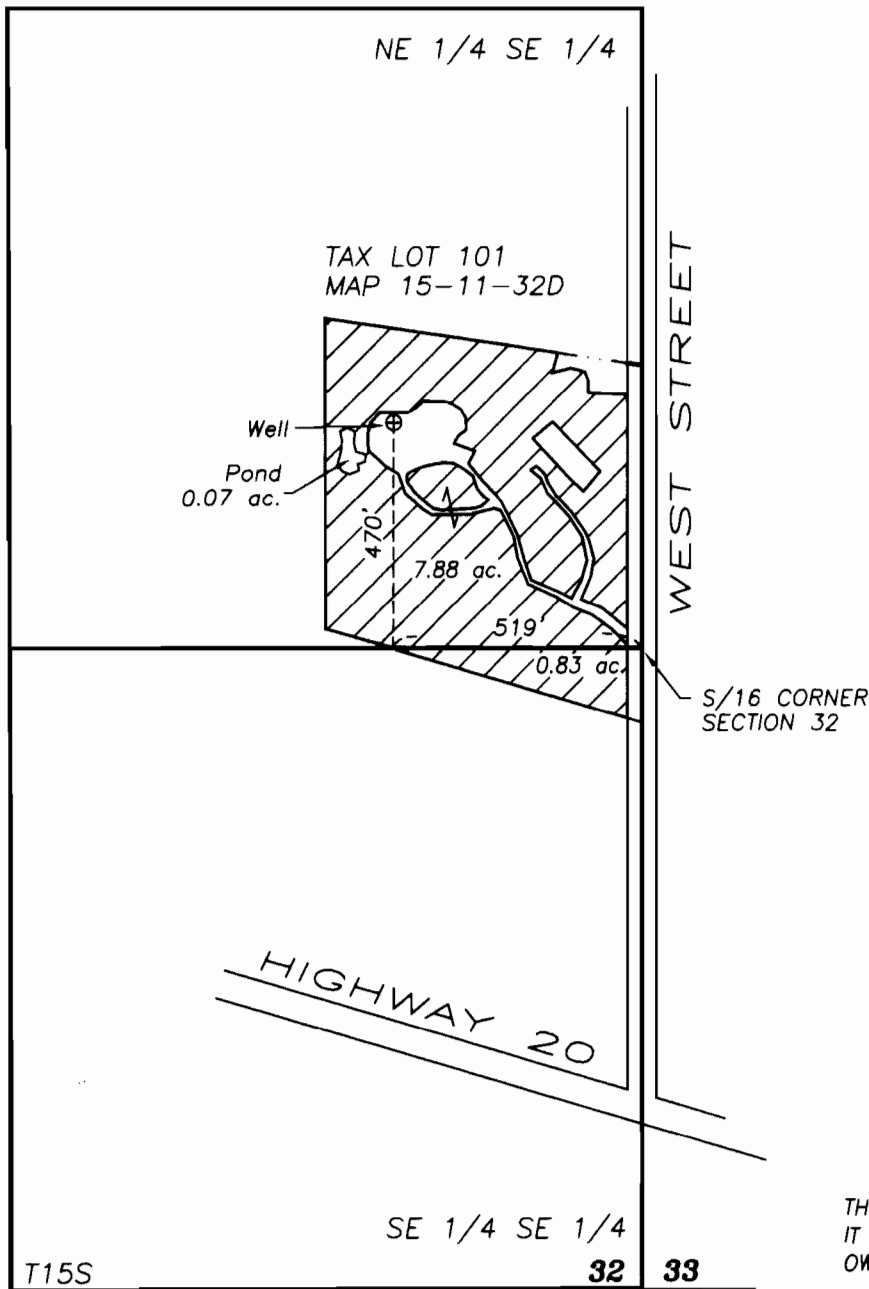

AREA BENEFICIALLY IRRIGATED UNDER
PERMIT G-13230

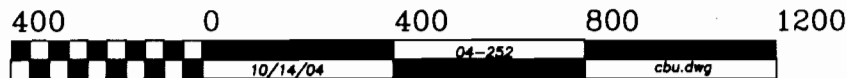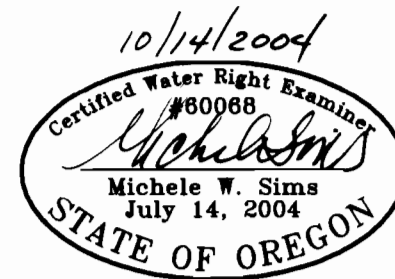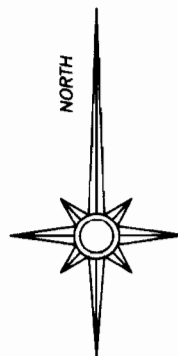

GRAPHIC SCALE - FEET

THIS MAP IS FOR THE PURPOSE OF IDENTIFYING THE LOCATION OF THE WATER RIGHT.
IT IS NOT INTENDED TO PROVIDE LEGAL DIMENSIONS OR LOCATIONS OF PROPERTY
OWNERSHIP LINES.