

Final Proof Survey

Application No. G-13986
Permit No. G-13240

FARM WELL

T.29 S., R.15 E., W.M.
Lake County, Oregon
Fremont National Forest

The corner location is based on mapping grade GPS.
The NAD 83 geodetic position of the monument is:
LAT. 43°01'40" N.
LONG. 120°58'40" W.

2 1/2" dia. Brass Cap on 1" dia. steel pipe,
per Lake County Surveyors Office, marked:





NW1/4SW1/4
Section 29



←--- Farm Well

Farm Well is located S.25°17'E., 402 ft.
from the West 1/4 corner of Section 29.
This measurement was from a survey
by John Thompson in 1995 for the water
right application. It differs slightly from
the GPS derived measurement.

The well location is based on mapping grade GPS.
The NAD 83 geodetic position of the well is:
LAT. 43°01'36" N.
LONG. 120°58'38" W.

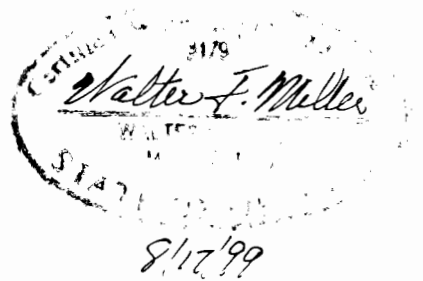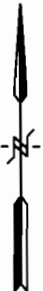

GRAPHIC SCALE 1" = 400'



0 400 800 1200

This map was prepared for the purpose of
identifying the location of a water right only
and is not intended to provide legal dimensions
or the location of property ownership lines.