



TOWNSHIP 14 SOUTH, RANGE 12 EAST, W.M.

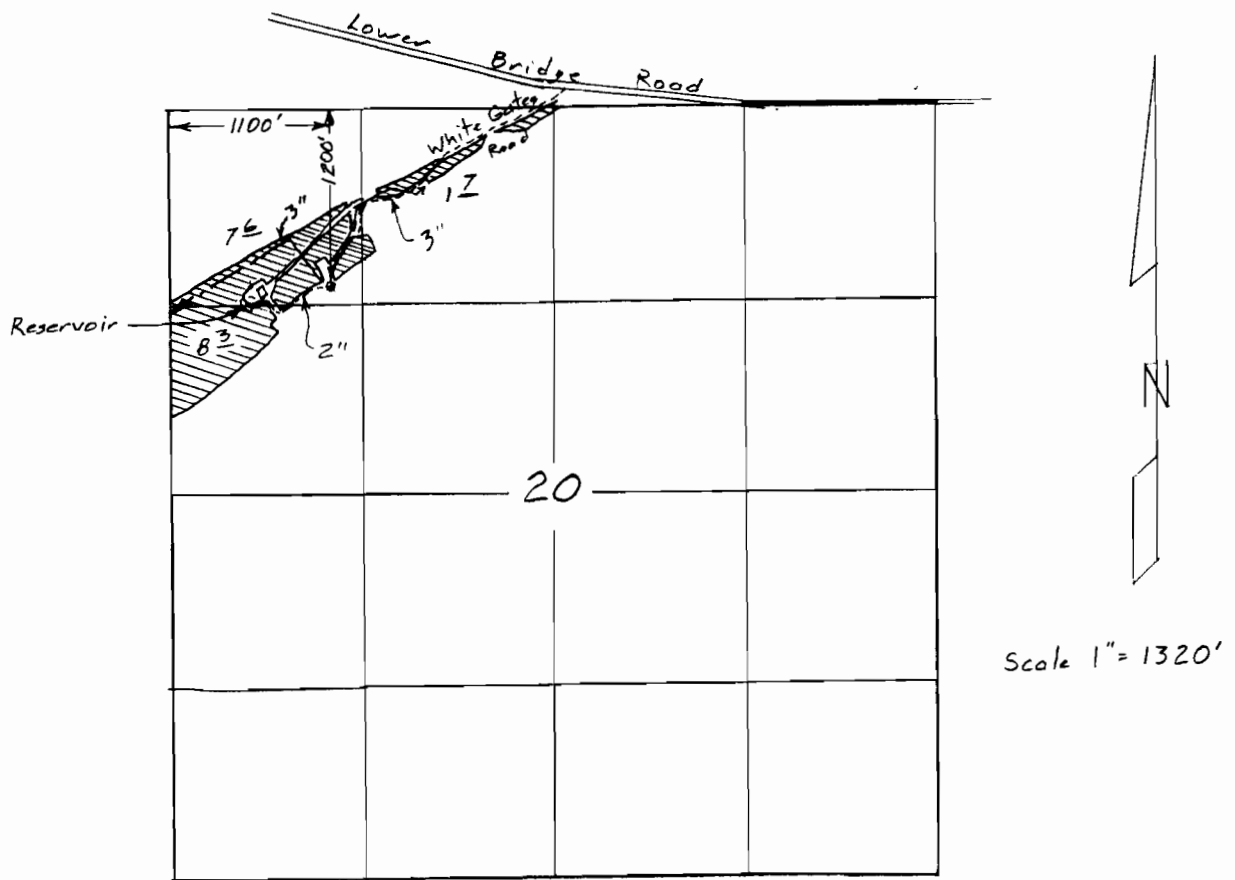

Surveyed June 21, 2002

Claim of Beneficial Use Map  
for  
EUGENE & JOYCE FALTUS

Application G-14356  
Permit G-13248

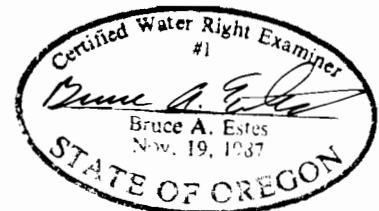

Renewal Dec 31, 2003

This map is for the purpose of locating a water right only and has no intent to provide legal dimensions or the location of property lines.

**ESTES SURVEYS, LLC**

PO Box 17519 60382 Arnold Rd  
Salem, OR 97305-7519 Bend, OR 97702  
(503) 585-7593 (541) 382-7391