



TOWNSHIP 4 SOUTH, RANGE 1 WEST, W.M.

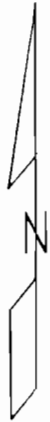

Scale 1" = 1320'

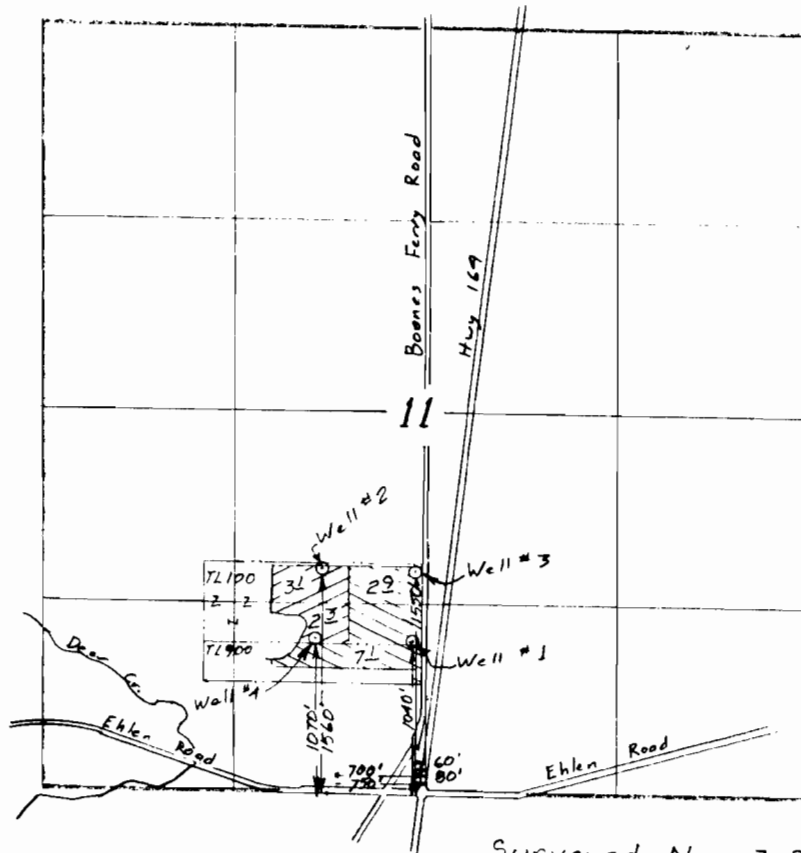


Surveyed Nov. 7, 2001

Claim of Beneficial Use Map
for
JEFF R. ALZNER

- Irrigation
- Nursery & Irrigation

Application G-14305
Permit G-13257

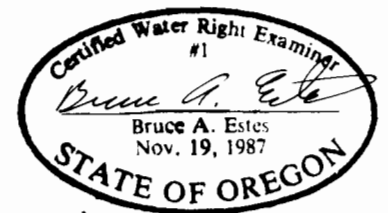

This map is for the purpose of locating a water right only and has no intent to provide legal dimensions or the location of property lines.

ESTES SURVEYS, LLC
 6293 Sunnyview Rd. NE 60382 Arnold Rd.
 Salem, OR 97305 Bend, OR 97702
 (503) 585-7593 (503) 382-7391