


SECTION 19, TWP.1 S. R.14 E. W.M.
 WASCO COUNTY, OREGON

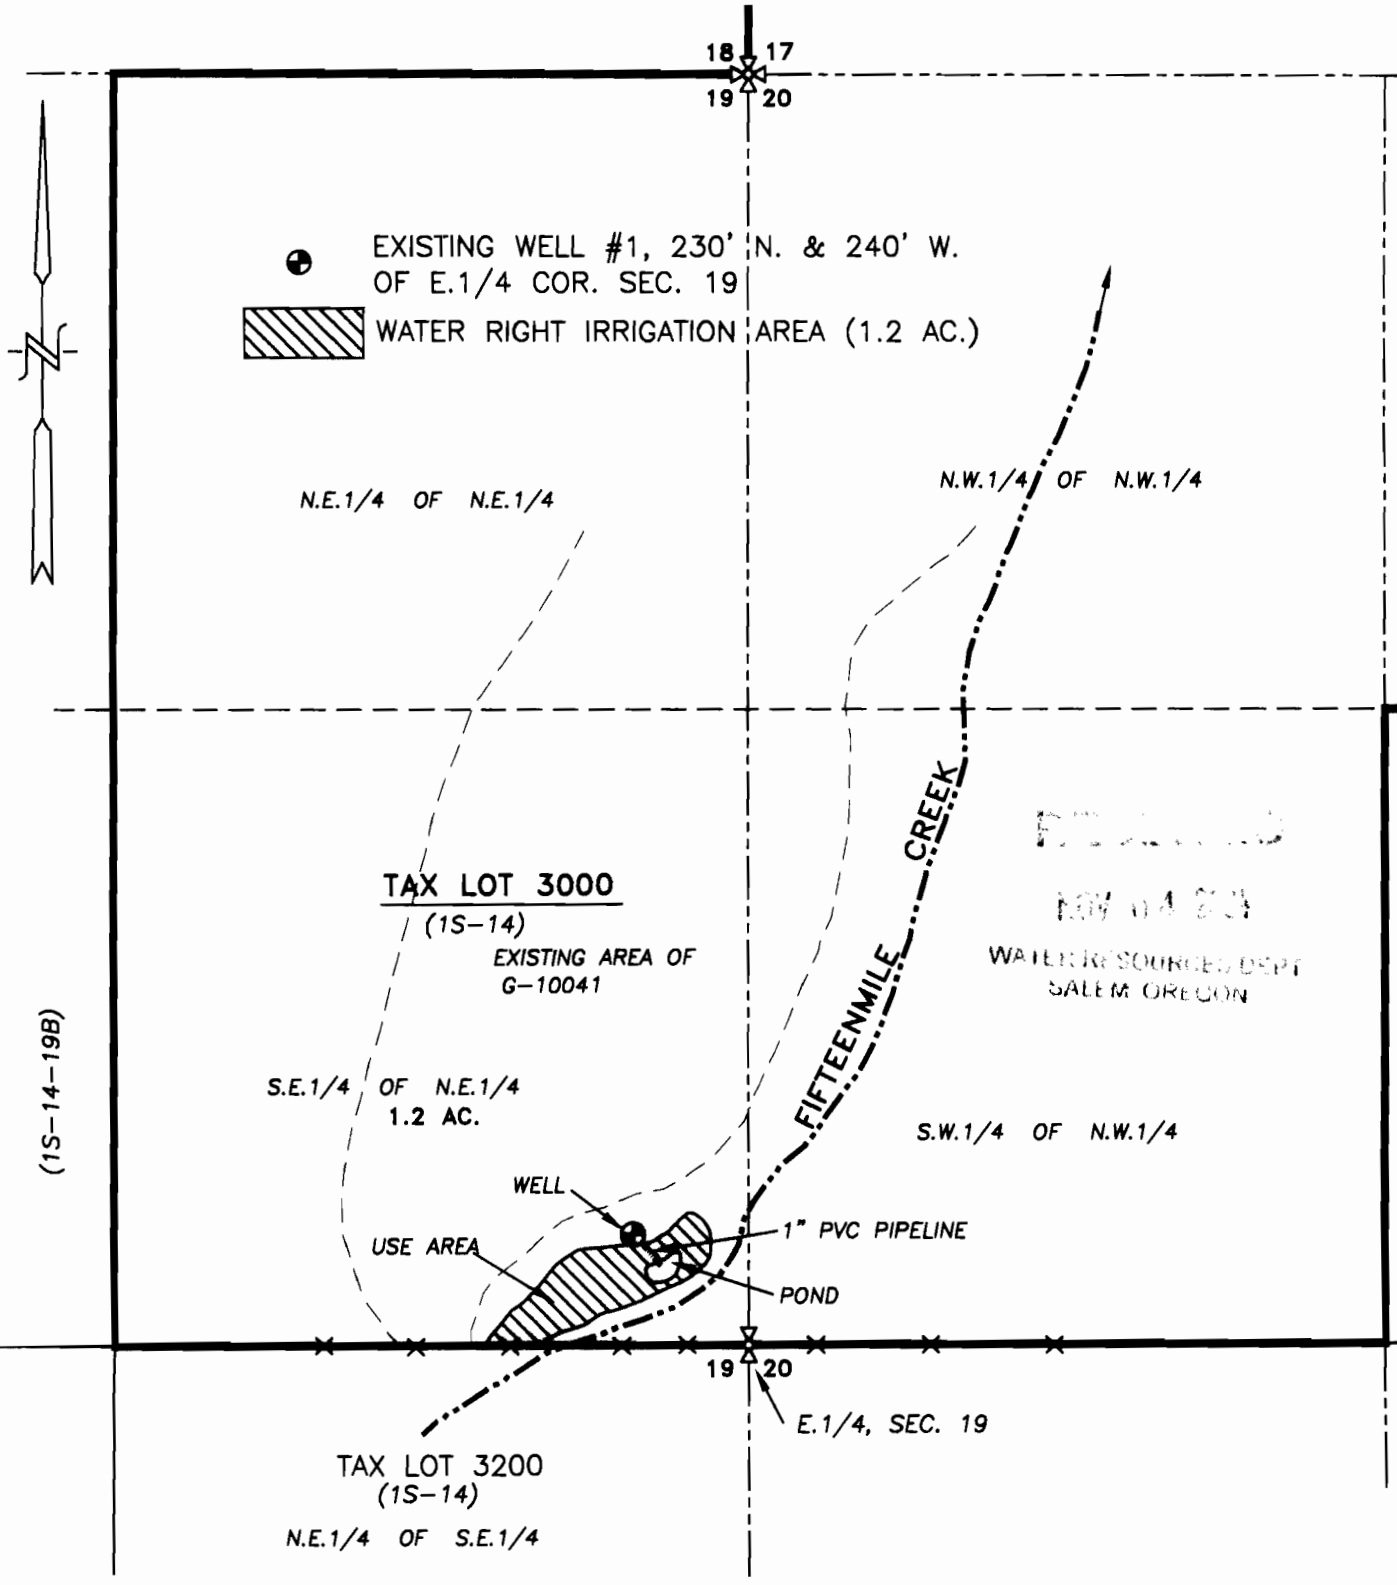

RECORDED
 NOV 04 2004
 WATER RESOURCES DEPT
 SALEM OREGON

CLAIM OF BENEFICIAL USE MAP

SCALE: 1" = 400'

APPLICATION No. G-14328

PERMIT No. G-13258

IN THE NAME OF:
ED A. KAYSER

DATE: NOVEMBER 3, 2004



EXPIRES: 06/30/06

NOTE:

"THIS MAP IDENTIFIES THE LOCATION OF THE WATER RIGHT ONLY AND IS NOT INTENDED TO PROVIDE DIMENSIONS OR LOCATE PROPERTY OWNERSHIP LINES."

BY: **TENNESON ENGINEERING CORP.**
 409 LINCOLN STREET,
 THE DALLES, OREGON. 97058
 PH. (541) 296-9177
 FAX (541) 296-6657



W.O. #11192