


T. 12 S. R. 2 & 3 W. W.M.

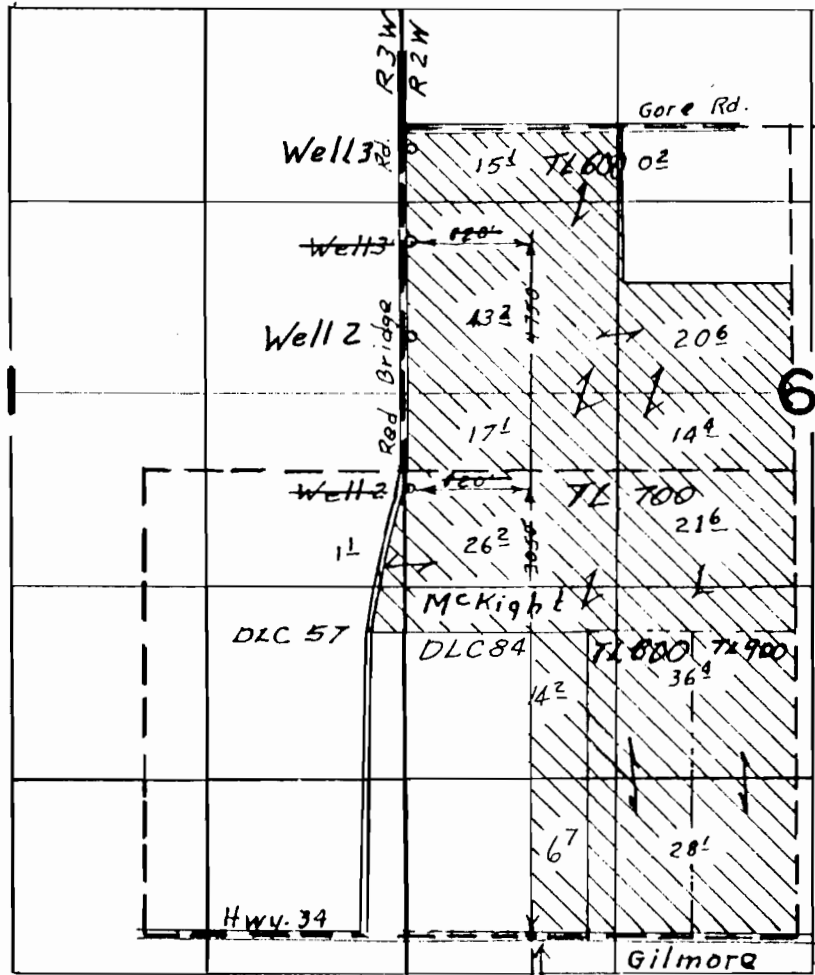

Well 2 : 4100'N & 820'W from NW Cor DLC 85
 Well 13 : 5400'N & 820'W " " " " "

WATER RIGHT MAP FOR JACKSON FARMS, LLC

RECEIVED

AUG 20 1997

WATER RESOURCES DEPT
 SALEM, OREGON

THIS MAP WAS PREPARED FOR THE
 PURPOSE OF IDENTIFYING THE LOCA-
 TION OF A WATER RIGHT ONLY AND IS
 NOT INTENDED TO PROVIDE LEGAL
 DIMENSIONS OR LOCATION OF PROPER-
 TY OWNERSHIP LINES.

Application No. D-14344
 Permit No. 010263

