



TOWNSHIP 14 SOUTH, RANGE 11 EAST, W.M.

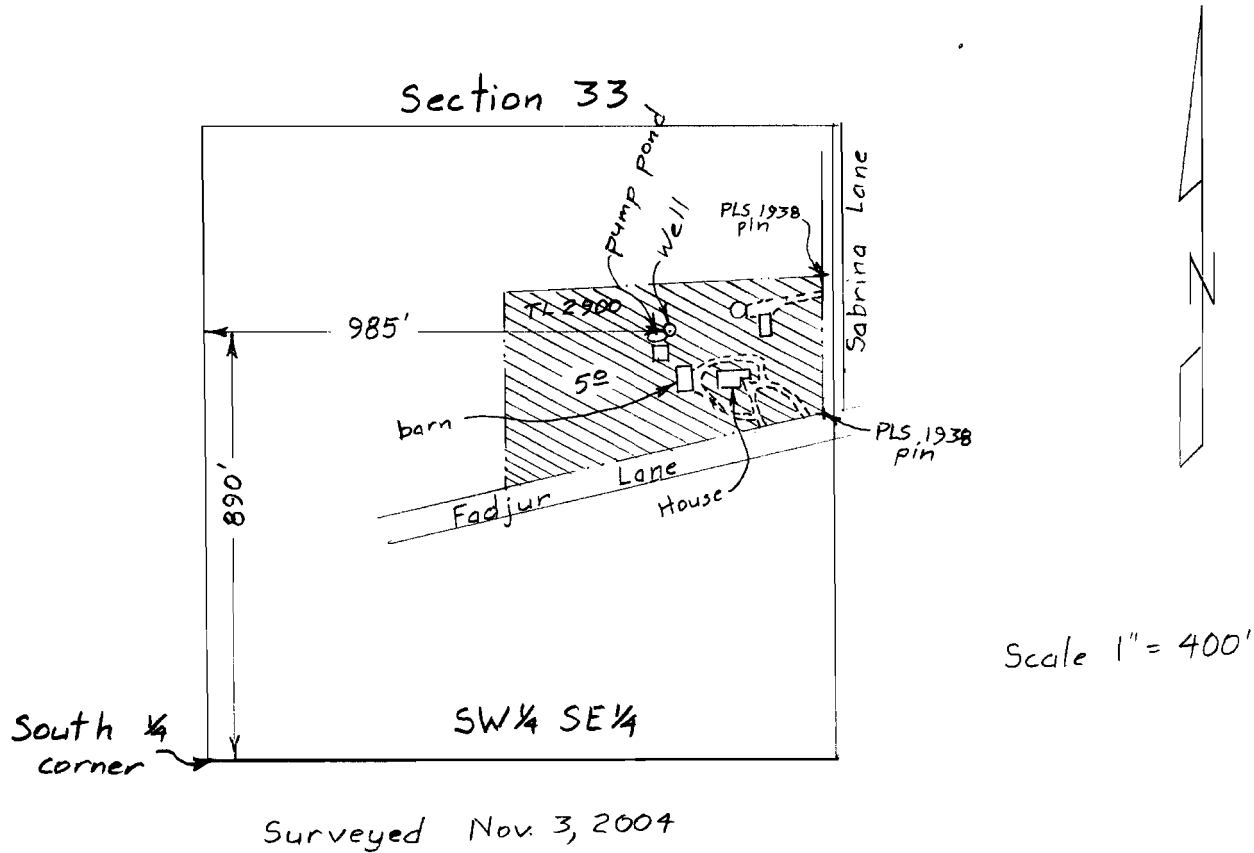

Claim of Beneficial Use Map
for
ANDREA ANDRESON

App. G-14451
Per. G-13278

RECEIVED

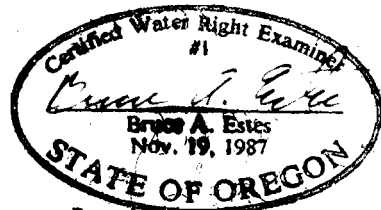

Renewal Dec 31, 2005

This map is for the purpose of locating a water right only and has no intent to provide legal dimensions or the location of property lines.

ESTES SURVEYS, LLC
 PO Box 17519 60382 Arnold Rd
 Salem, OR 97306-7519 Bend, OR 97702
 (503) 585-7593 (541) 382-7391