


# T14S, R5W, W.M.

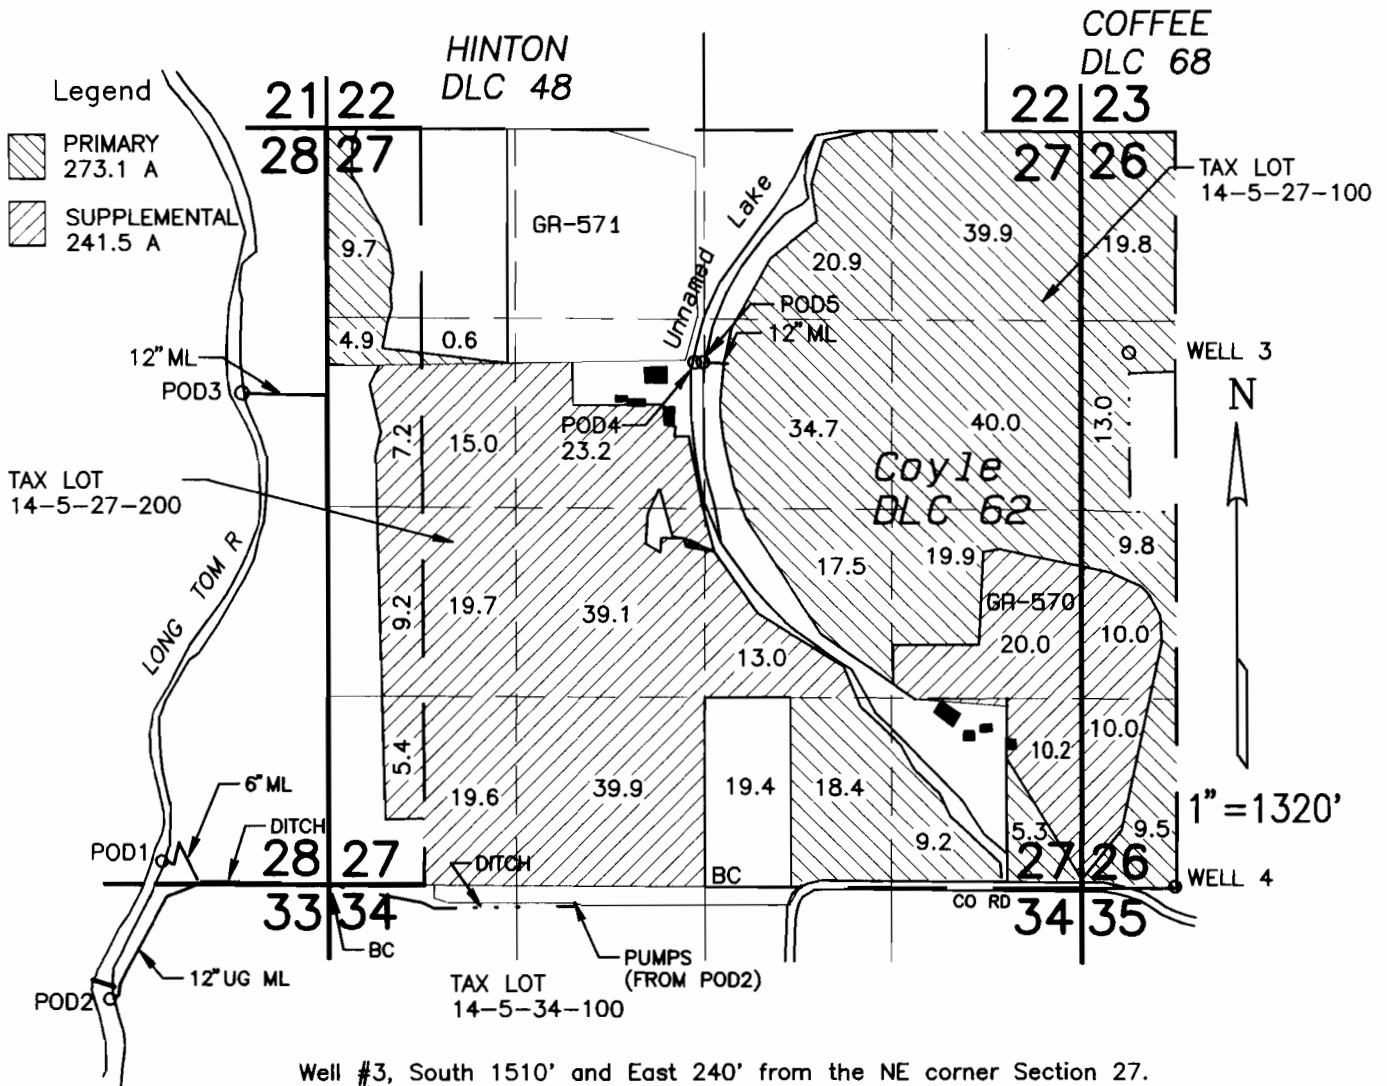


Well #3, South 1510' and East 240' from the NE corner Section 27.  
 Well #4, North 10' and West 12' from the SE corner DLC 62.

## CLAIM OF BENEFICIAL USE MAP

IN THE NAME OF  
**HUBBARD FARMS INC**

APPLICATION G-12631      PERMIT G-13284

Prepared September 25, 2002  
 PARSONS SURVEYING  
 1915 S.E. Stone St.  
 Corvallis, OR 97333  
 (541) 752-7515  
 Project No. 0217

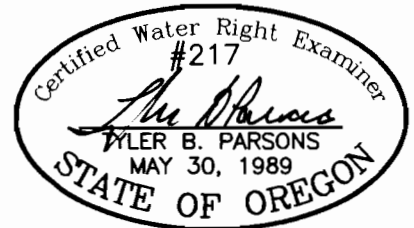

This map is for location of Water Right ONLY and does not constitute a boundary survey.

MAP 1 OF 2


EXP: 12/31/02

RECEIVED



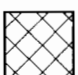

OCT 03 2002

WATER RESOURCES DEPT  
 SALEM, OREGON

# T14S, R5W, W.M.

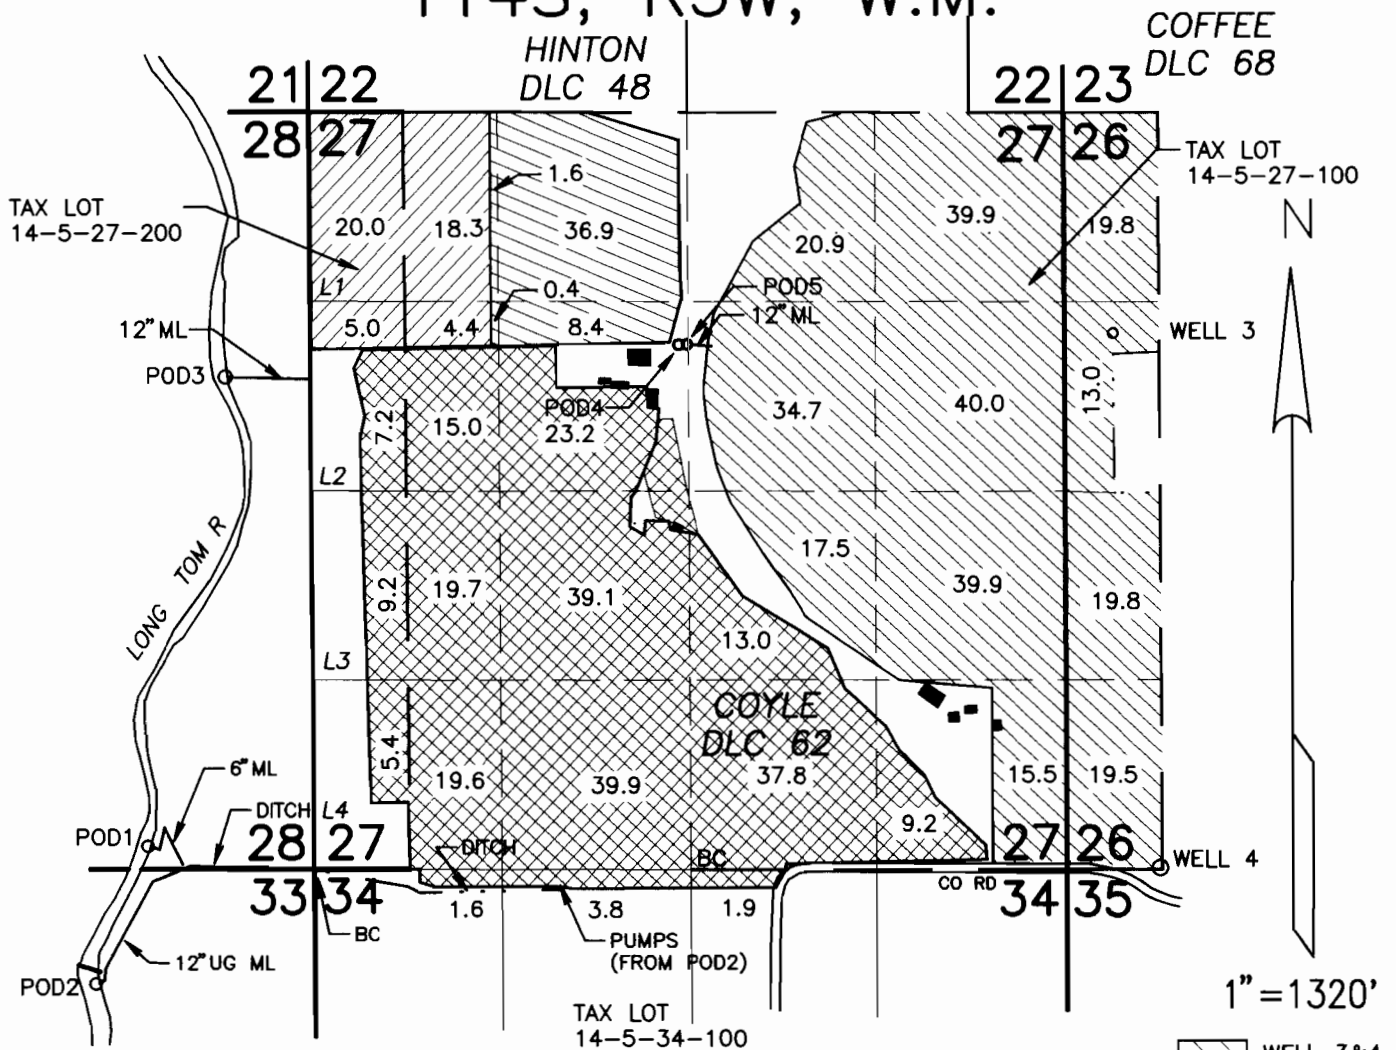

- POD 1, NORTH 160 FT & WEST 1140 FT FROM SW CORNER SEC 27 (NOT IN USE)
- POD 2, SOUTH 720 FT & WEST 1490 FT FROM SW CORNER SEC 27
- POD 3, SOUTH 1850 FT & WEST 600 FT FROM NW CORNER SEC 27
- POD 4, NORTH 3670 FT & WEST 2700 FT FROM SE CORNER SEC 27
- POD 5, NORTH 3670 FT & WEST 2650 FT FROM SE CORNER SEC 27
- WELL 3, SOUTH 1510 FT & EAST 240 FT FROM NE CORNER SEC 27
- WELL 4, NORTH 10 FT & WEST 12 FT FROM SE CORNER DLC 62

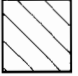-  WELL 3&4  
G-13284  
280.5 AC
-  POD3  
53304  
47.7 AC
-  POD2  
53304  
245.6 AC
-  POD4  
53304  
47.3 AC


## WATER USAGE SOURCES - 2002 CLAIM OF BENEFICIAL USE MAP

IN THE NAME OF  
**HUBBARD FARMS INC**

APPLICATION S-71790      PERMIT 53304  
APPLICATION G-12631      PERMIT G-13284  
TRANSFER T-8104  
TRANSFER T-8856

Prepared September 25, 2002  
PARSONS SURVEYING  
1915 S.E. Stone St.  
Corvallis, OR 97333  
(541) 752-7515  
Project No. 0217

This map is for location of Water Right ONLY and does not constitute a boundary survey.

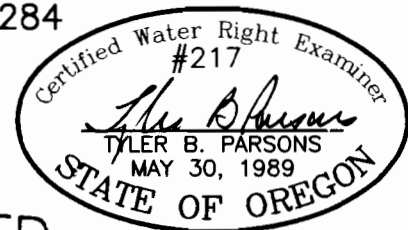

MAP 2 RECEIVED

EXP: 12/31/2002

OCT 03 2002

WATER RESOURCES DEPT.  
SALEM OREGON