



T.7S. R.1E. Section 27

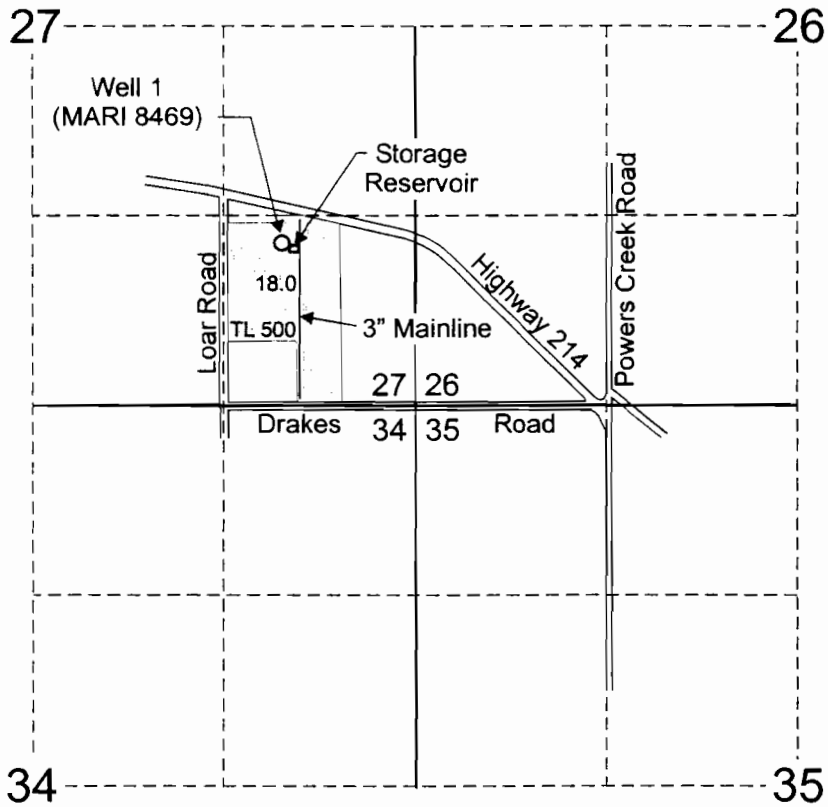


Well 1 (MARI 8469) is located 1,130 feet north and 920 feet west from the SE corner of Section 27.

 Area (18.0 Acres) irrigated under Application G-14303, Permit G-13295.

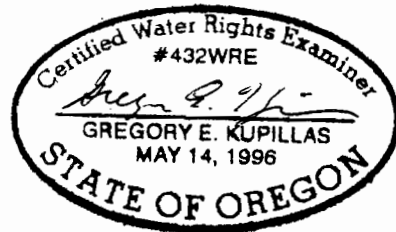

EXPIRATION DATE: 6/30/05

Scale: 1" = 1,320'

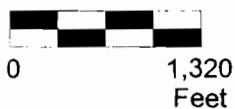

This map was prepared for the purpose of identifying the location of a water right only and is not intended to provide legal dimensions or location of property ownership lines.



Claim of Beneficial Use Map

Delbert and Barbara Hupp
T.7S. R.1W. Sec. 27, Tax Lot 500

Pacific Hydro-Geology Inc.