


Randy & Cindy Norton
2111 1/2 1st St. SE
Wilson, Washington, OR
97162

Randy & Cindy Norton
2111 1/2 1st St. SE
Wilson, Washington, Oregon
97162-1609

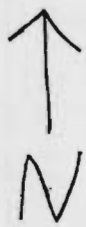


RECEIVED

SEP 29 1997

WATER RESOURCES DEPT.
SALEM, OREGON

* From Corner
124272913.6 East
238.0 South

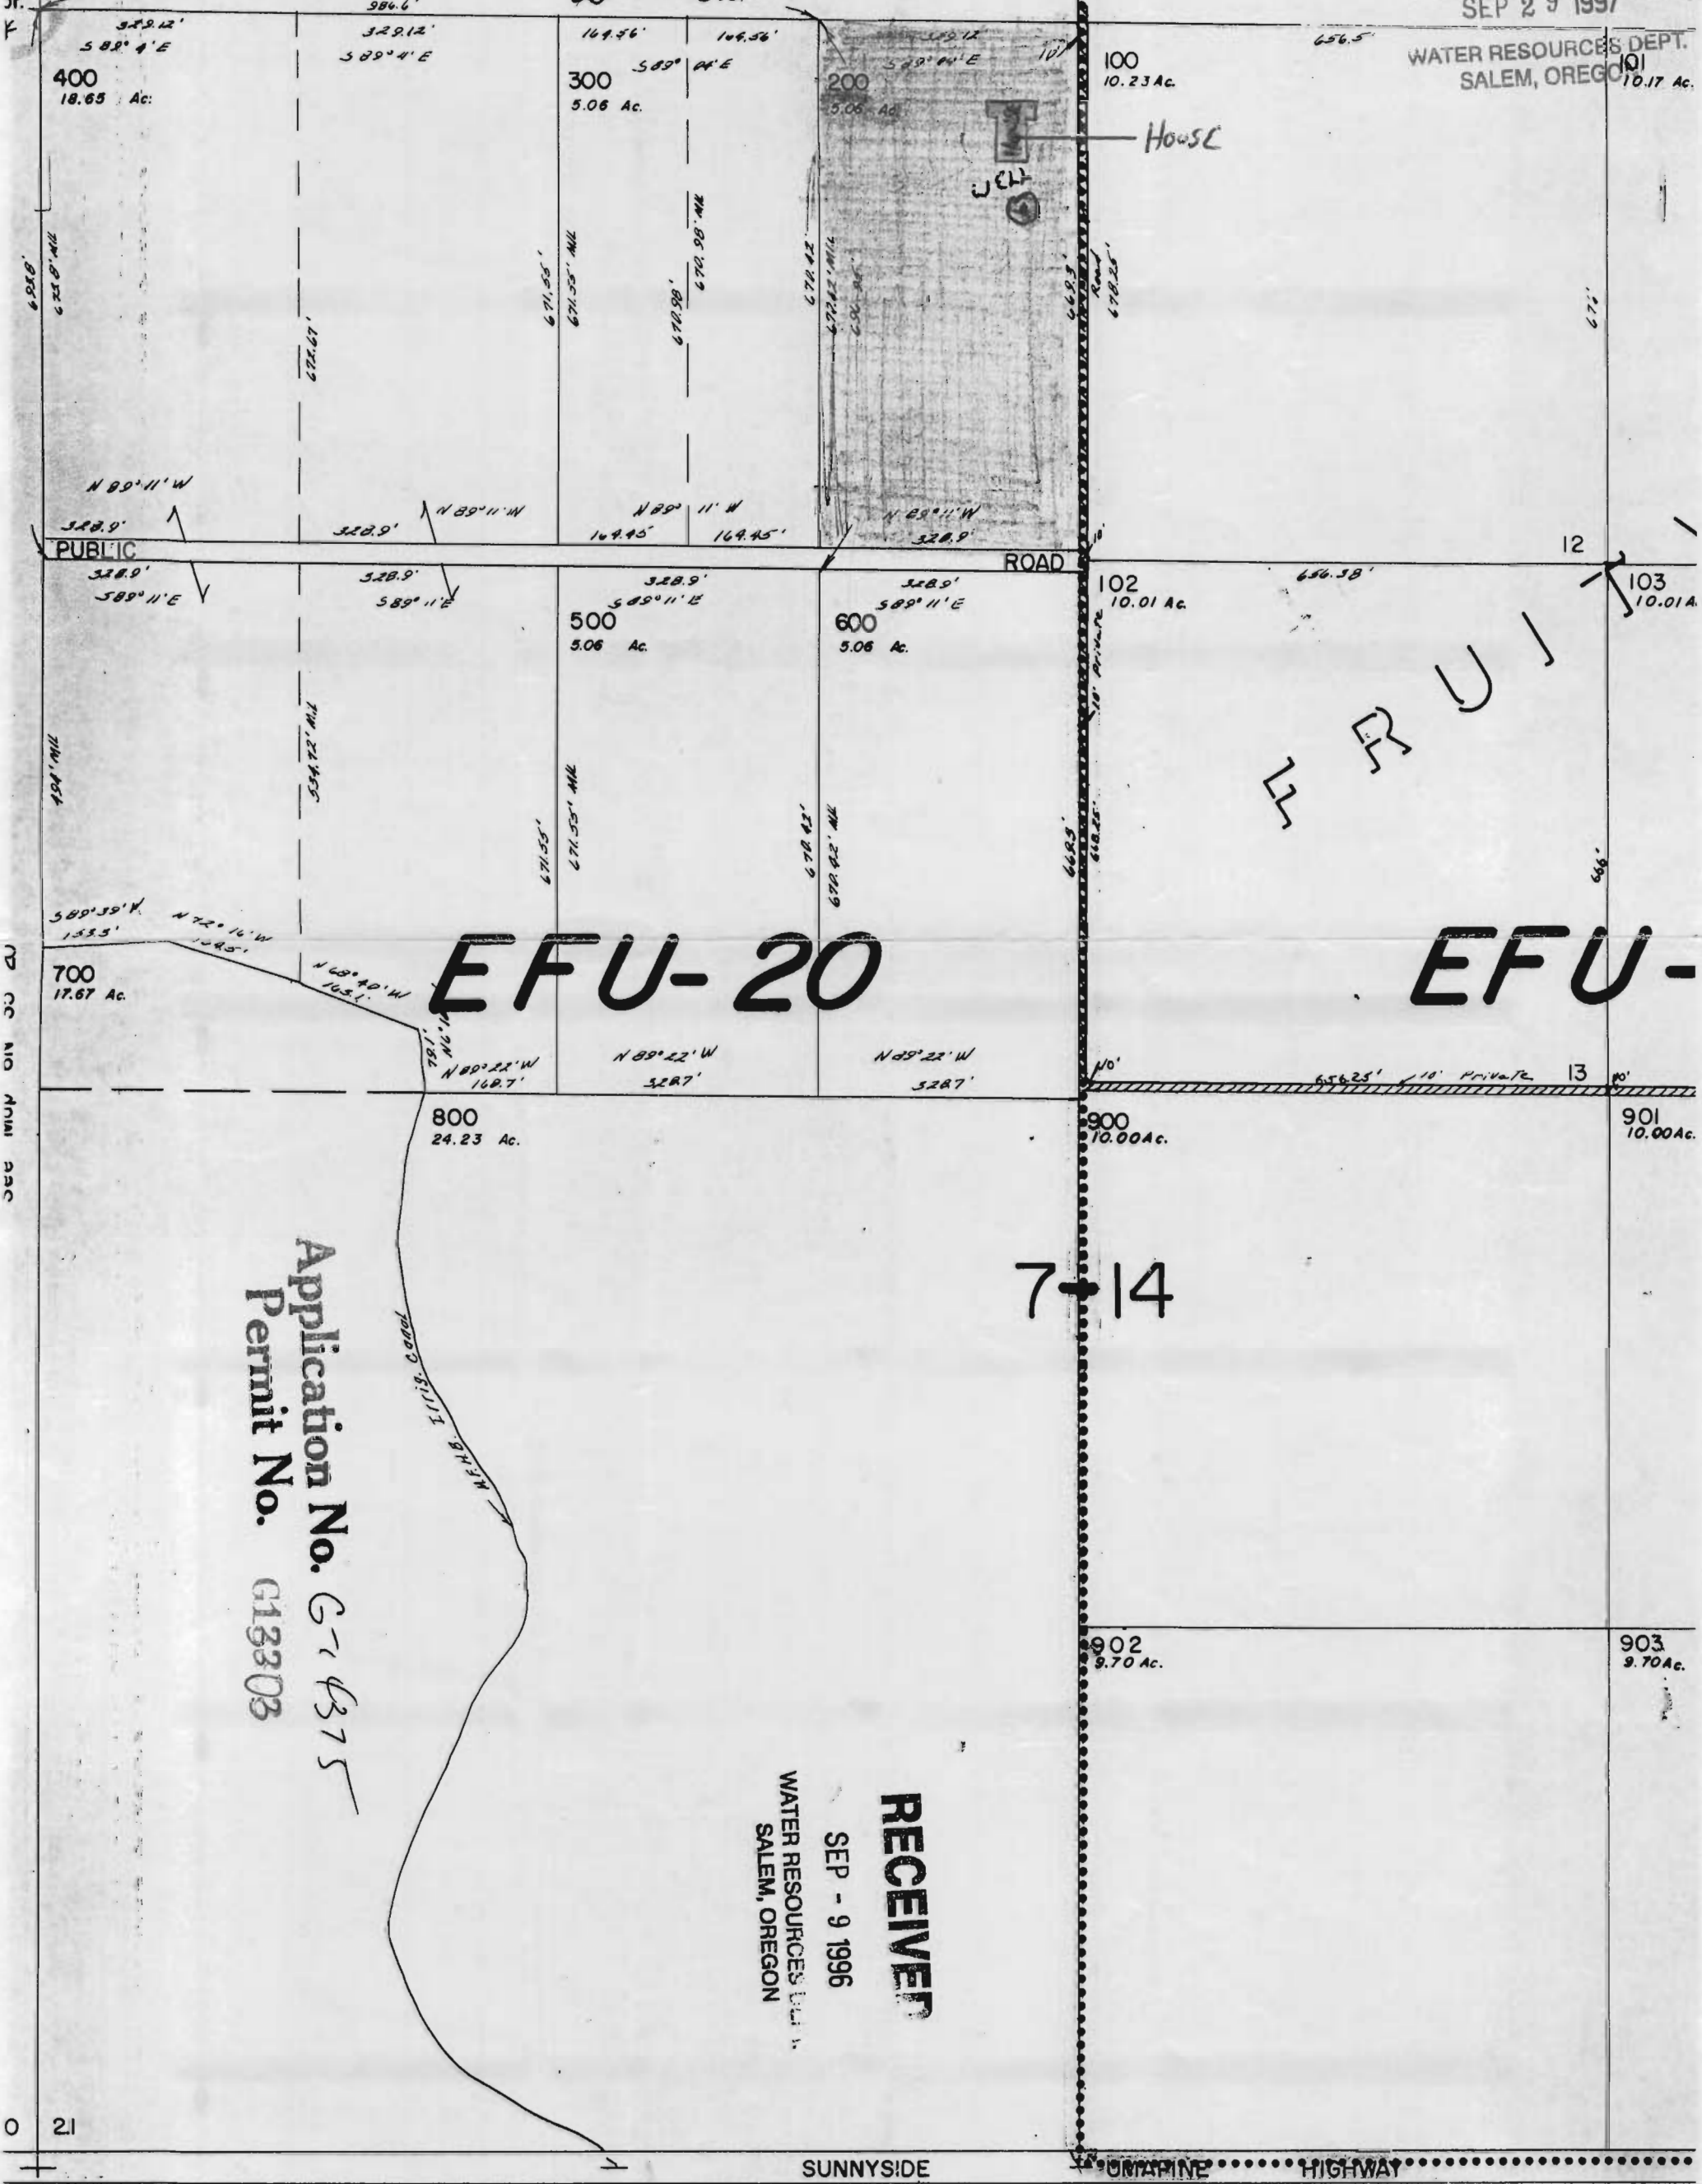

Application No. G-14375
Permit No. G13303

RECEIVED
SEP - 9 1996
WATER RESOURCES DEPT.
SALEM, OREGON