
## T.7S., R.2W., W.M.

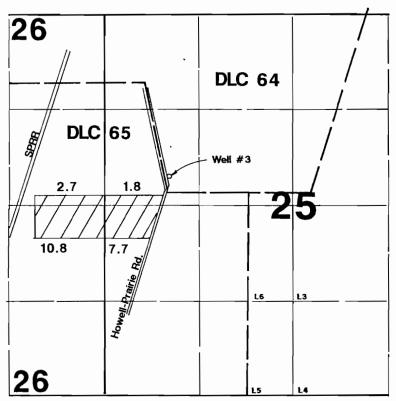



Area Irrigated

Well #3 located 400'N & 1740'W from center Section 25.

## RECEIVED

**JAN 23** 1997

WATER RESOURCES DEPT. SALEM, OREGON

**Application Map** 

## **Clarence Simmons**

Application #:6-1444 Permit #: G13306

