


RECEIVED

MAY 01 1997

WATER RESOURCES DEPT
SALEM, OREGON

T.7 S. R. 1 E. W.M.

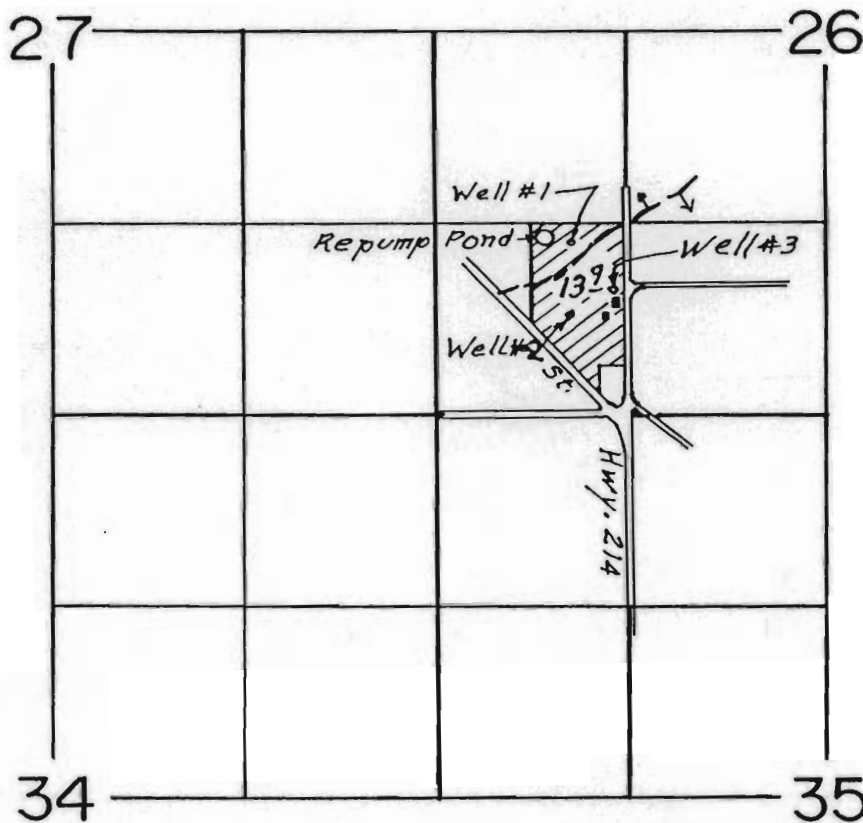

Well #1: 1175' N & 930' E From SW Cor Sec 26
 Well #2: 680' N & 920' E " " " " "
 Well #3: 960' N & 1220' E " " " " "


Powers Cr
Silver Cr
 Drainage Boundry

6-4510

Permit No. G13333

WATER RIGHT MAP FOR
 CASCADE WEST TREES, INC.

THIS MAP WAS PREPARED FOR THE
 PURPOSE OF IDENTIFYING THE LOCA-
 TION OF A WATER RIGHT ONLY AND IS
 NOT INTENDED TO PROVIDE LEGAL
 DIMENSIONS OR LOCATION OF PROPER-
 TY OWNERSHIP LINES.

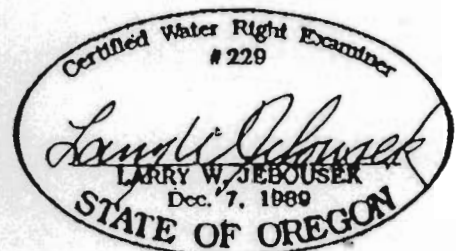

WAC-900R 22-215

3/18/97 *aw*