

SEC.36 TWP.5S. RGE.1W. WM
MARION COUNTY, OREGON

MAR 18 1997

LEGEND

- LINE TYPES
- TAX LOT BOUNDARIES
 - OLD PROPERTY LINES
 - RIVERS, LAKES, ETC.
 - CREEKS, POND, ETC.
 - RAILROADS
 - TAX CODE BOUNDARIES
 - SUBDIVISION BOUNDARIES


- SYMBOL TYPES
- CONTROL POINTS
 - SURVEY MONUMENTS
 - G.L.D. CORNERS (APPROX) (FOUND)
 - SECTION
 - 1/4 SEC
 - 1/16 SEC
 - D.L.C.

OREGON STATE PLANE
COORDINATE SYSTEM
GRID MARKS - NAD 27

NUMBERS
TAX CODE NO.
000 00 00 0


ACREAGE - ALL ACREAGES EXCLUDE
ANY PORTION THAT MAY LIE
WITHIN THE INDICATED PUBLIC
RIGHT OF WAYS.

TICK MARKS - WHEN A TICK MARK IS
INDICATED ON THE EXTENSION OF
A LINE, THEN THE DIMENSION GOES
TO THE TICK MARK. GENERALLY THIS
IS USED WHEN DIMENSIONS GO INTO
PUBLIC RIGHT OF WAYS.

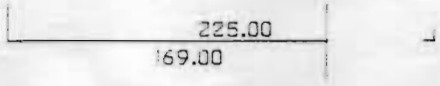


ARROWS ARE USED WITH DIMENSIONS
IN AREAS OF GREATER COMPLEXITY.

WARNING: This map was
created by digitizing
assorted existing maps.
NO Research was done.
Created for Assessor's
Office use ONLY.

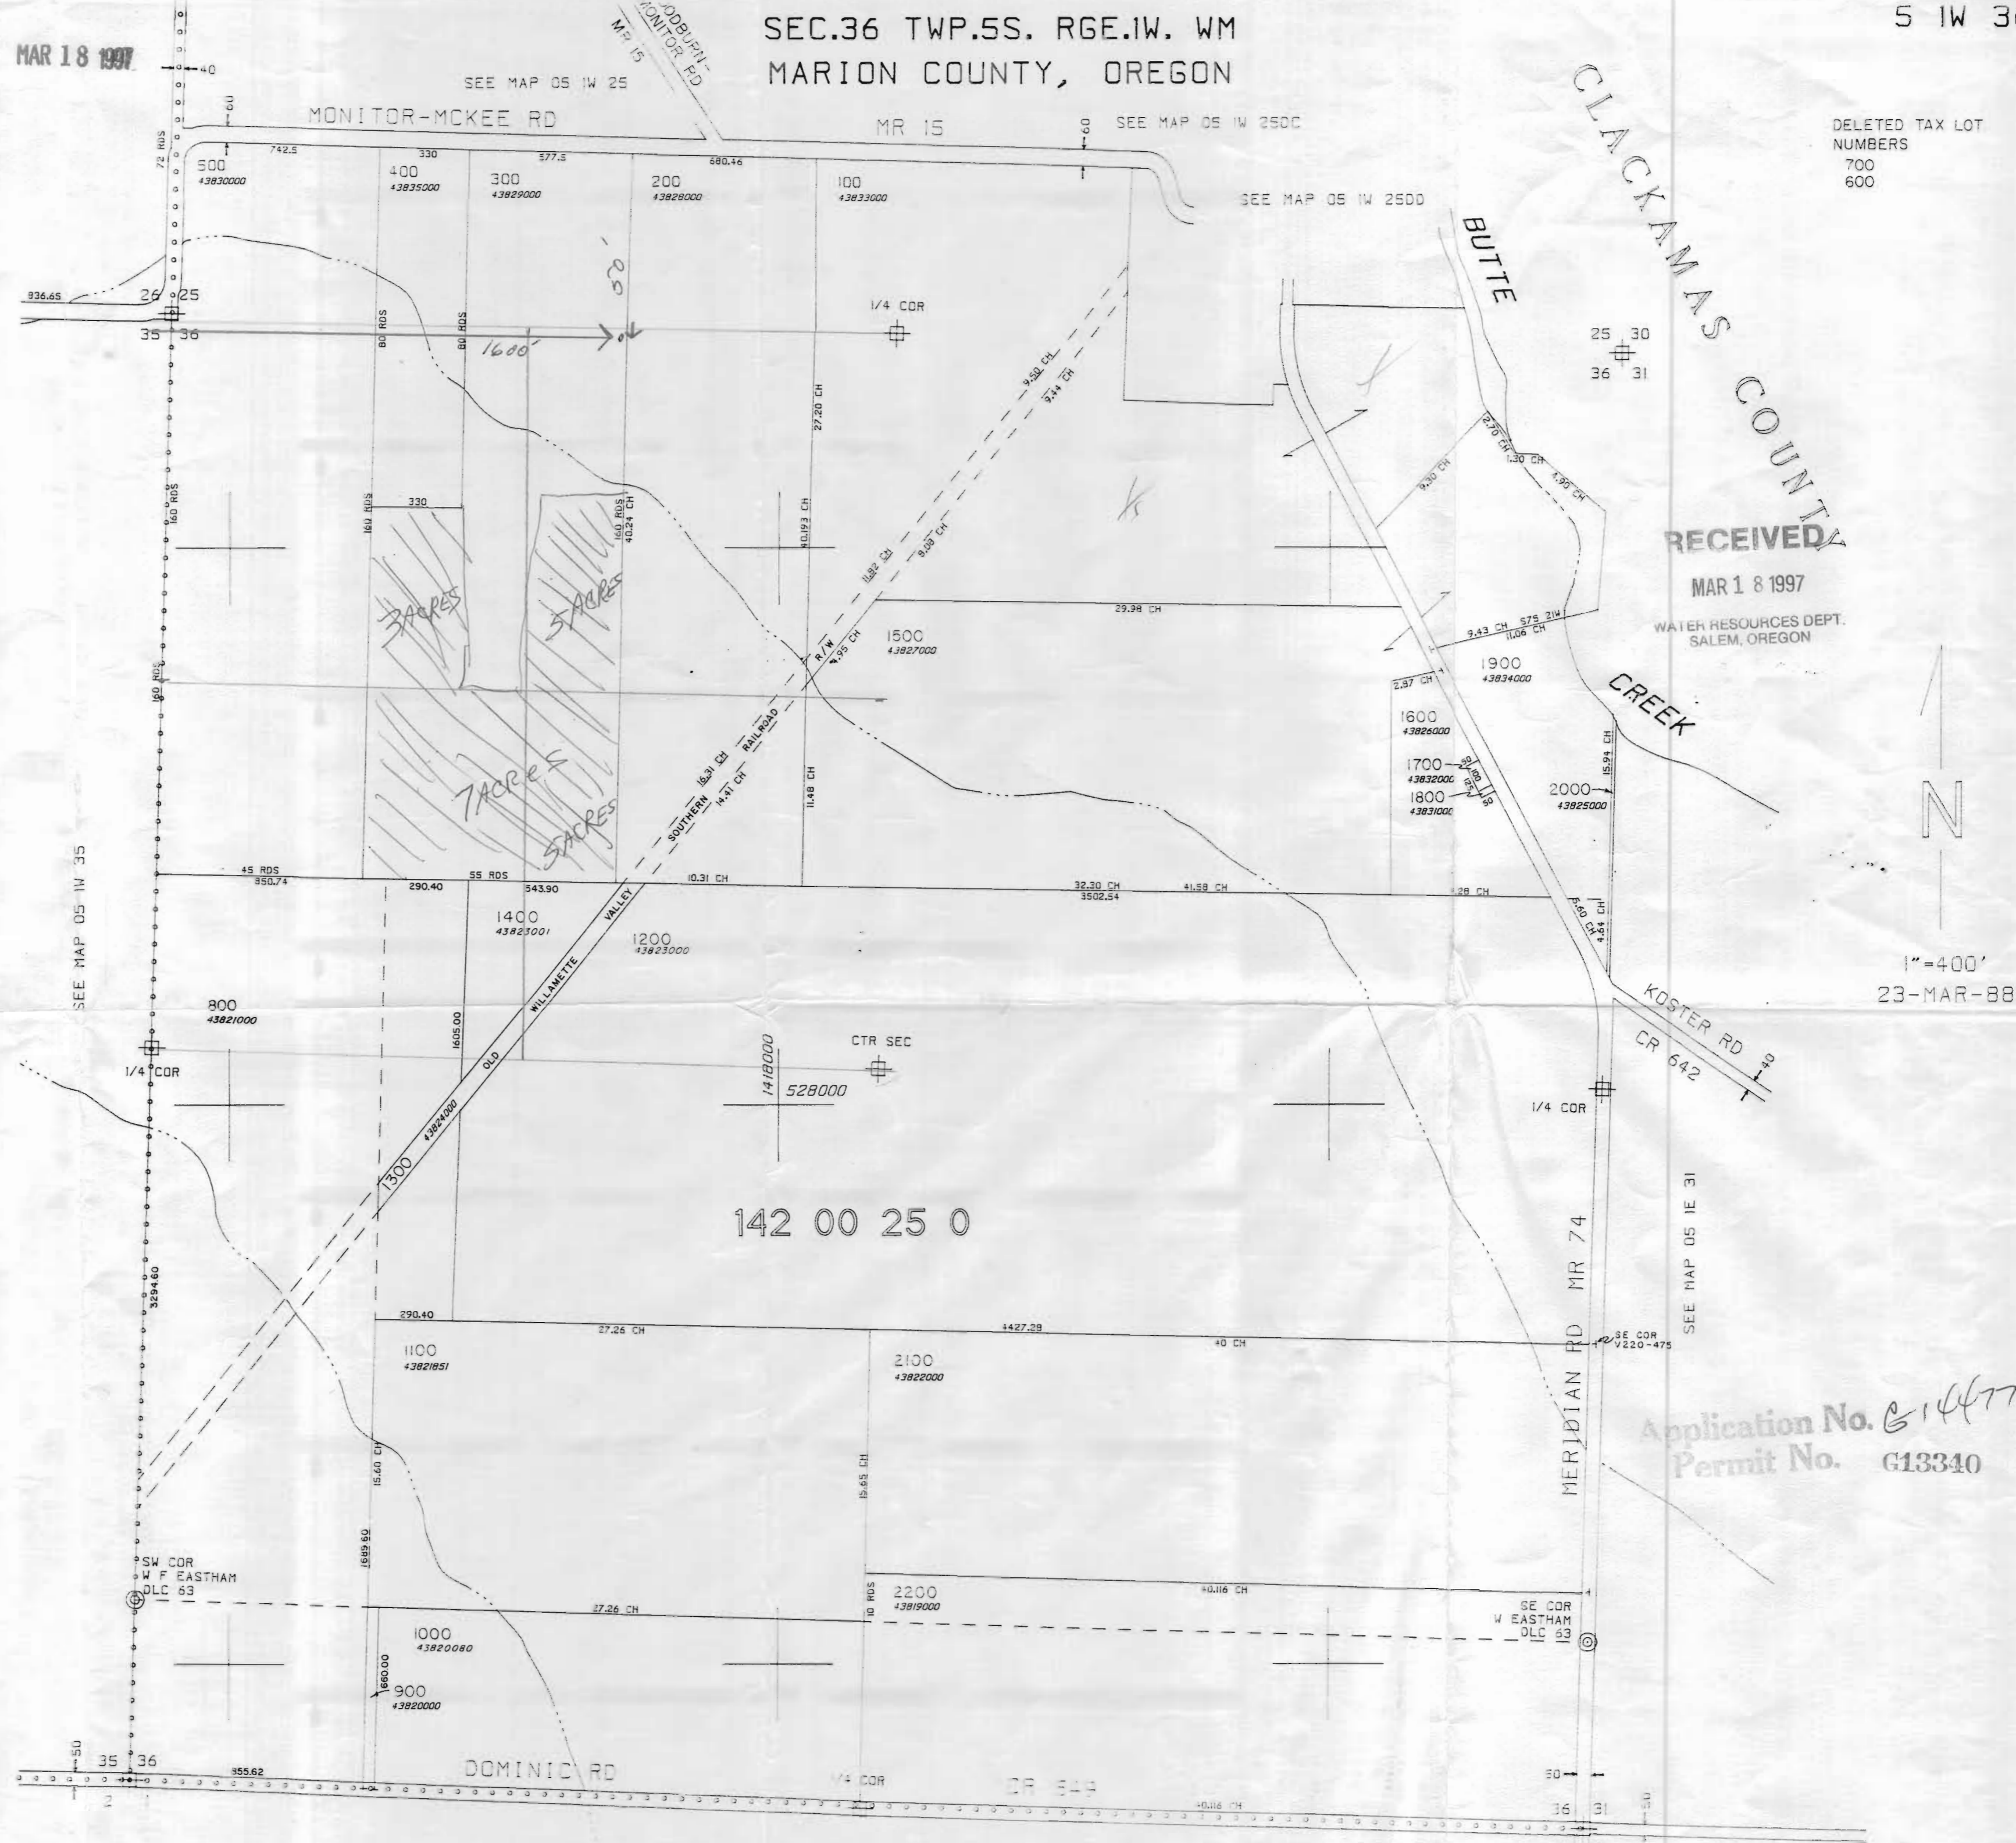

DELETED TAX LOT
NUMBERS
700
600

RECEIVED
MAR 18 1997
WATER RESOURCES DEPT.
SALEM, OREGON

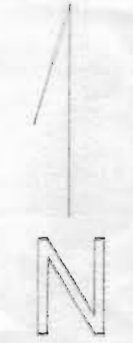

1"=400'
23-MAR-88

Application No. G1477
Permit No. G13340