


RECEIVED
MAY 15 1996
WATER RESOURCES DEPT.
SALEM, OREGON

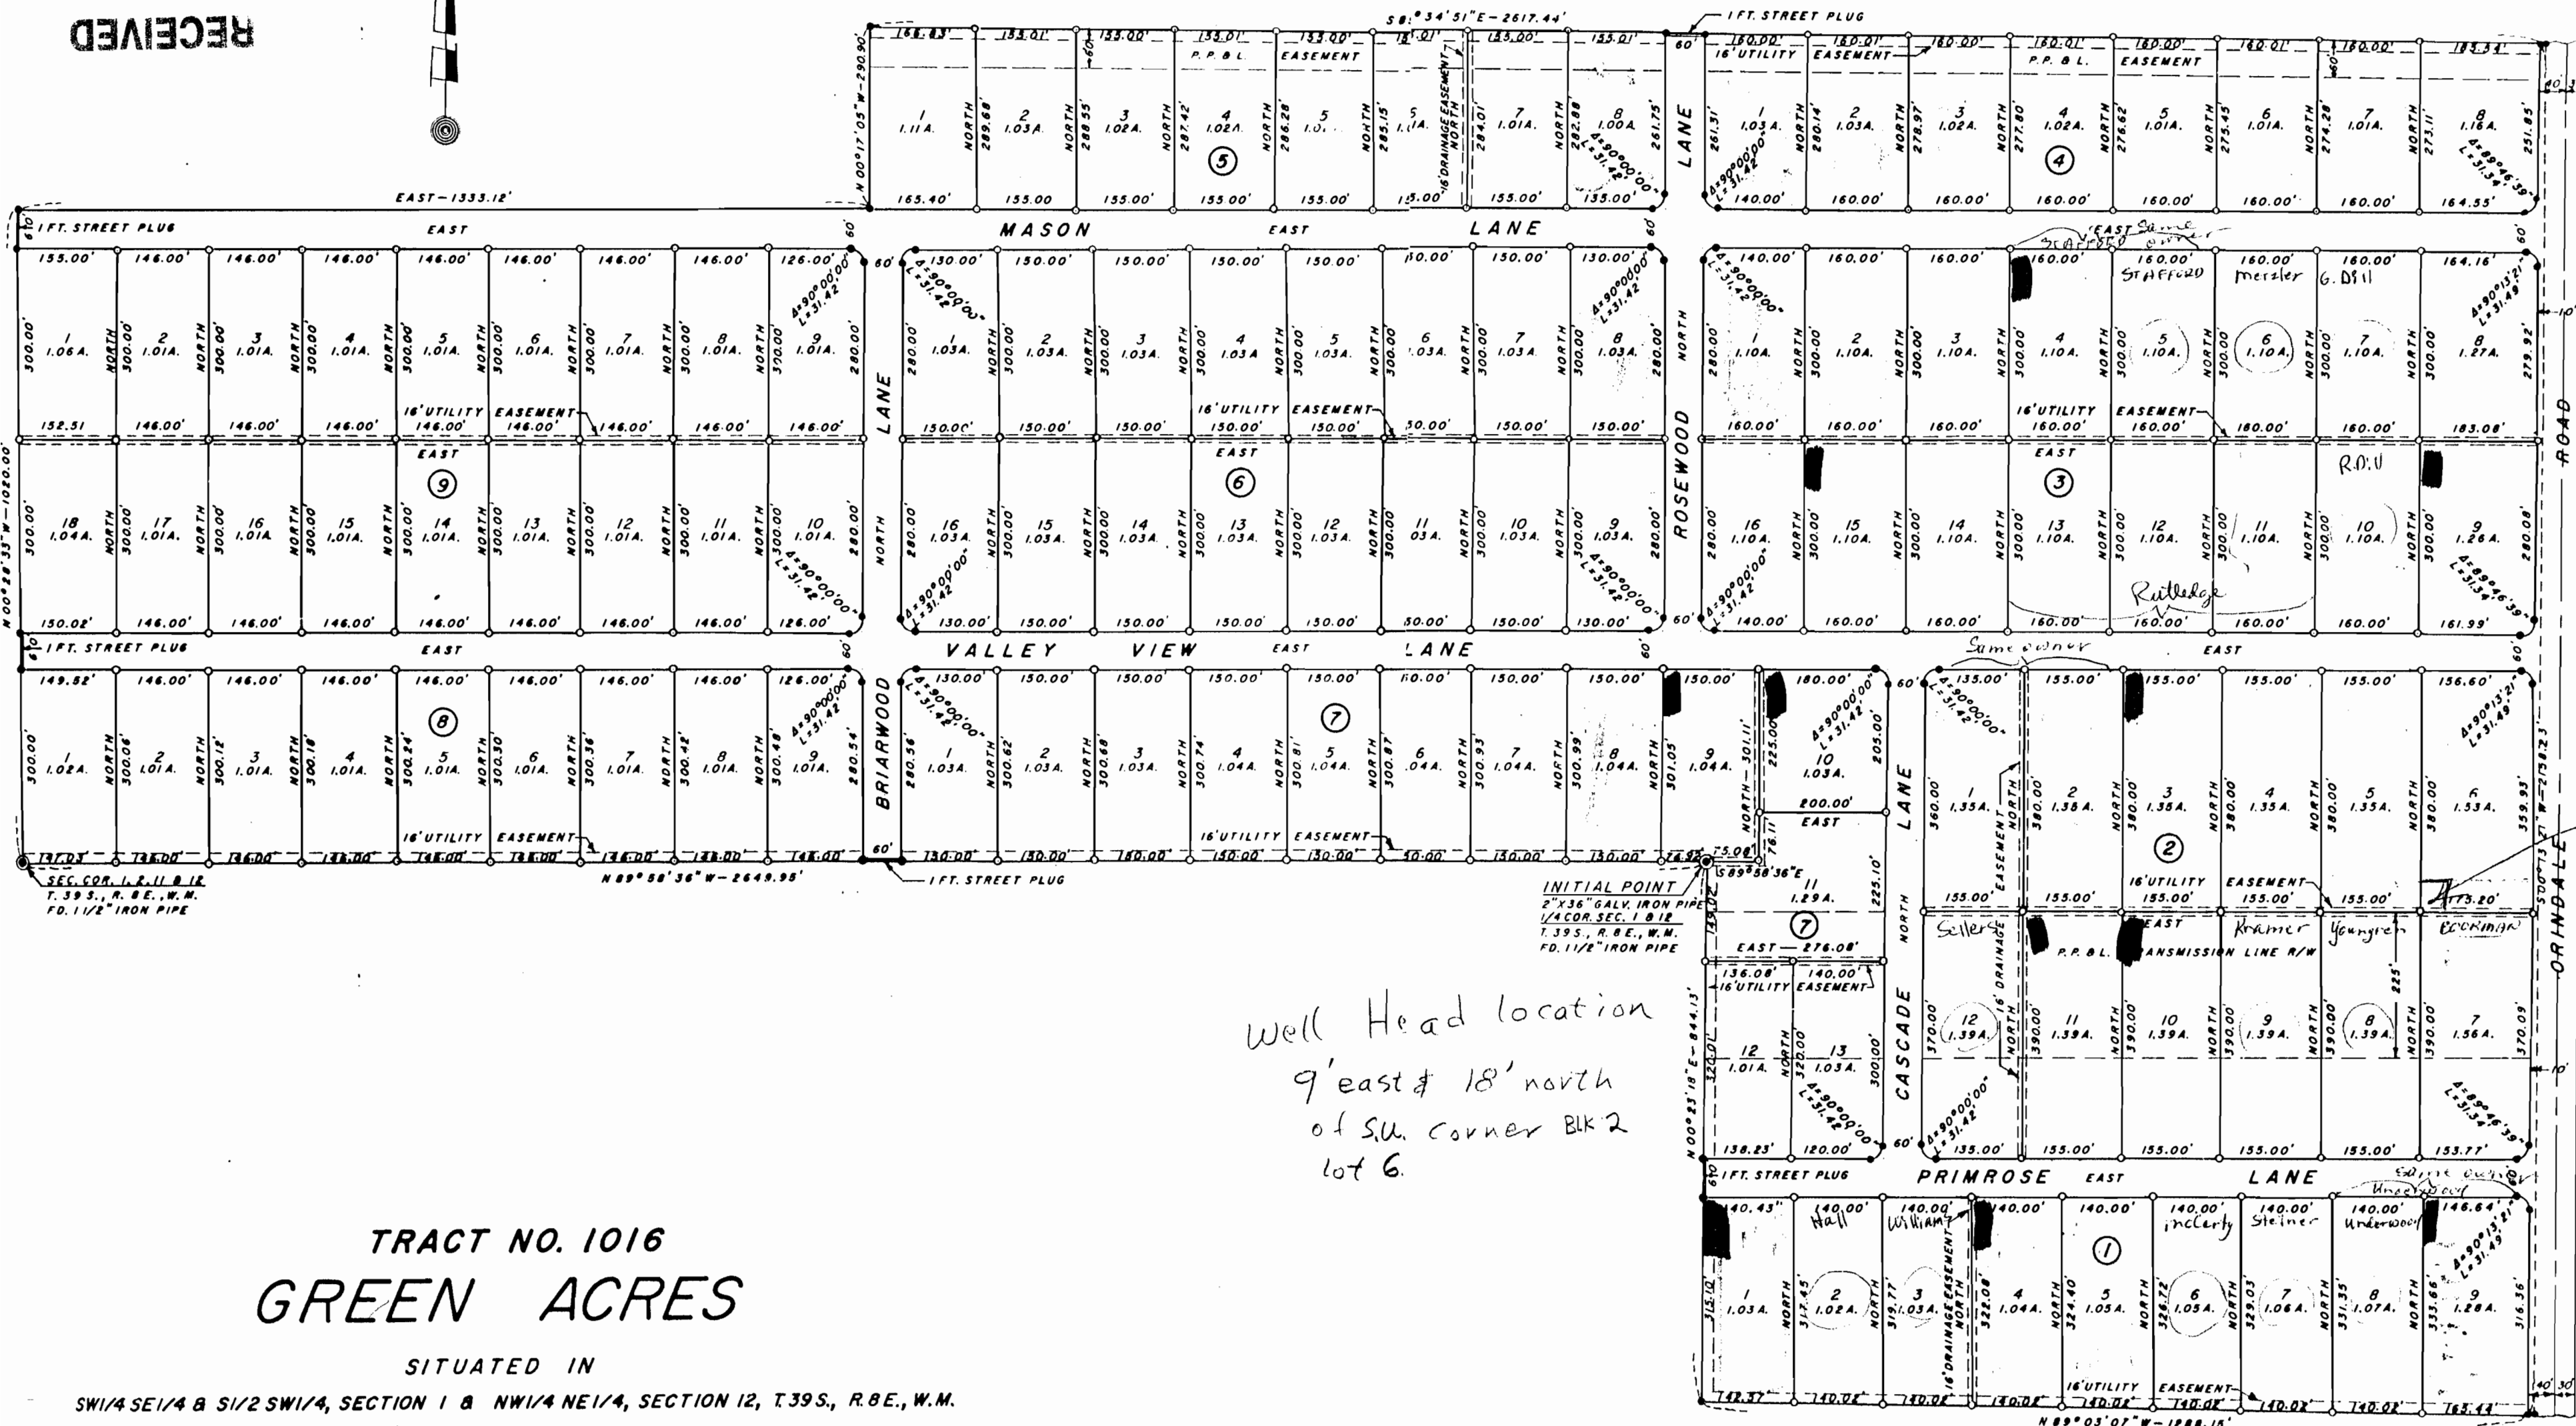

TRACT NO. 1016
GREEN ACRES

SITUATED IN


SW1/4 SE1/4 & S1/2 SW1/4, SECTION 1 & NW1/4 NE1/4, SECTION 12, T.39S., R.8E., W.M.

KLAMATH COUNTY, OREGON

SCALE: 1" = 200 FT.

DATE: MAY, 1970

G. ROBERT LECKLIDER—REGISTERED ENGINEER

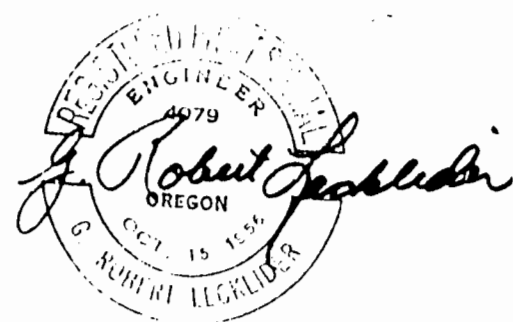

Application No. 6-14313
Permit No. 013345

NOTE: ALL BEARINGS BASED ON SOLAR OBSERVATION.
MINIMUM 20 FT. BUILDING SETBACK ON ALL STREET LINES.
ALL FILLETS HAVE 20 FT. RADIUS.
• DENOTES 5/8" X 30" IRON ROD.
○ DENOTES 1/2" X 30" IRON ROD.

54 Lots in District
11 — Unoccupied
2 of which are
2nd floor of
people already
with water
from our well