


# T.4S., R.1W., W.M.

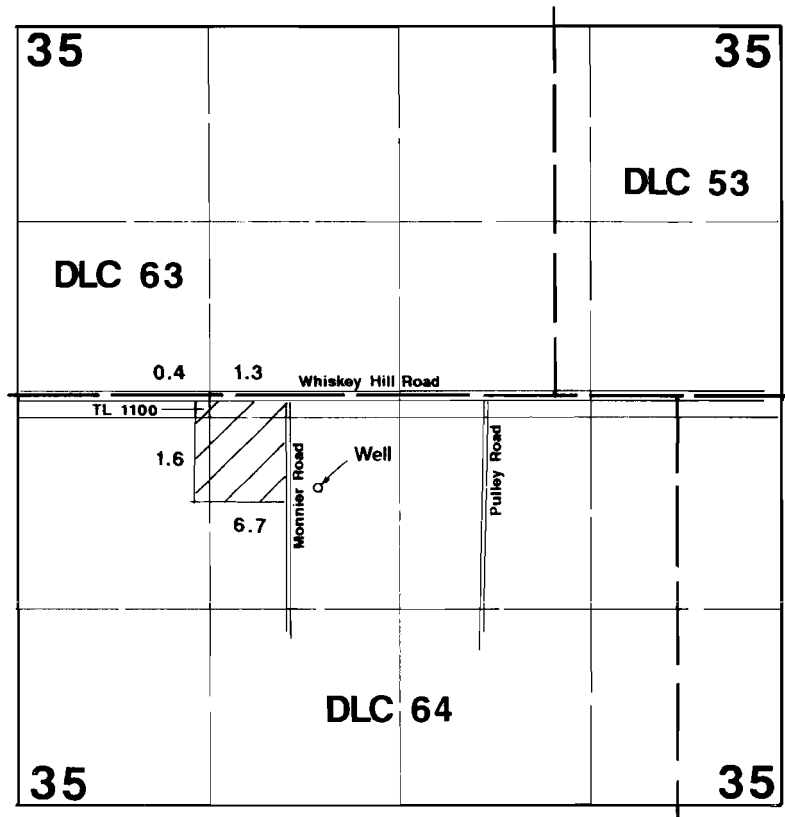

1" = 1320

Well is located 615' S & 2490' W from the NW corner of DLC 64.

## Final Proof Survey

In Name of

## Dieringer Nursery

Application #: G-14491

Permit #: G-13352

Surveyed on September 18, 2003 by JM Schuette

This Map Was Prepared For The Purpose Of Identifying The Location Of A Water Right Only And Is Not Intended To Provide Legal Dimensions Or Location Of Property Ownership Lines.

