


THIS MAP WAS PREPARED FOR ASSESSMENT PURPOSE ONLY.

NE1/4NW1/4 SEC 4 T3S R38E. WM.
UNION COUNTY


3S 38 4BA

1"=100'

SEE MAP 25 38 33

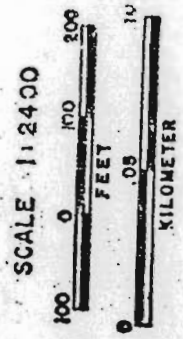

SCALE 1:2400

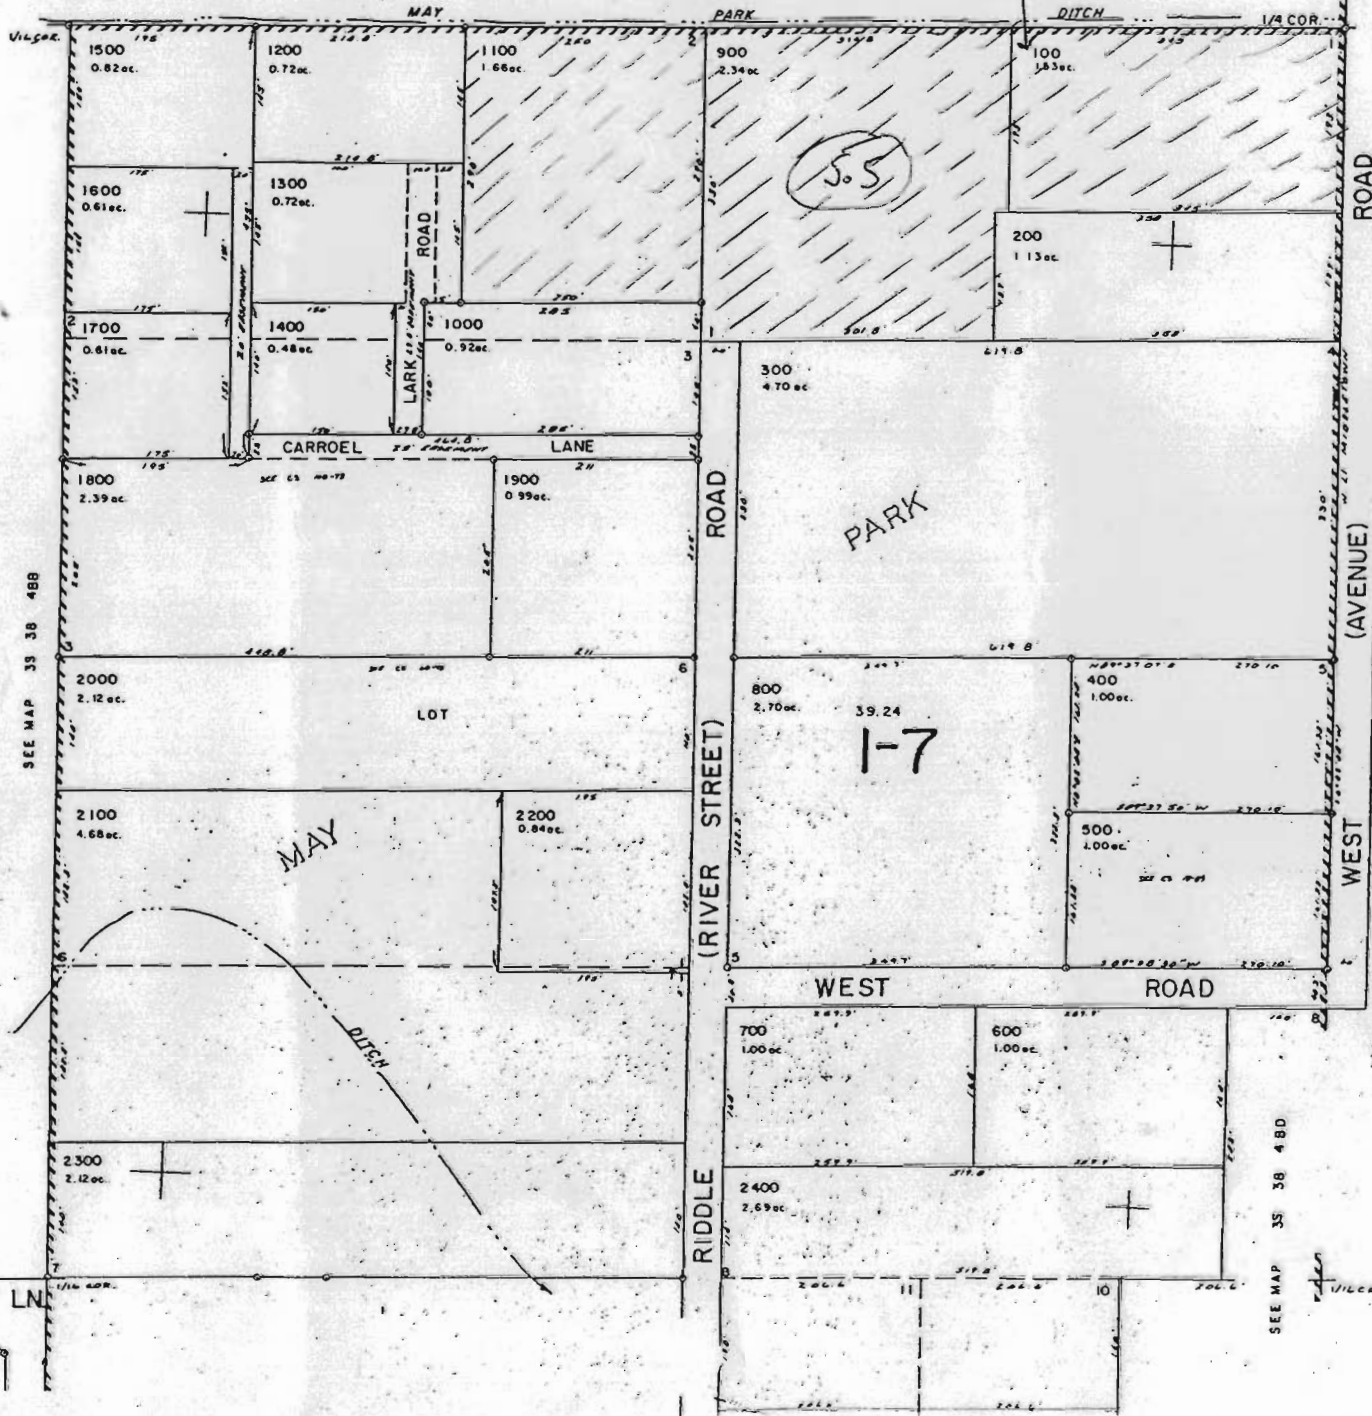

well from NE section corner lot #1 346' west and 10' south of 1/4 corner of lot #1



Application No. G14567
Permit No. G13355

RECEIVED
JUL 15 1993
DEPT. OF REVENUE STATE OF OREGON
ASSESSMENT & APPRAISAL DIV.

WATER RESOURCES DEPT.
SALEM, OREGON

JUN 24 1997

RECEIVED

NOTE: NO. 1 STREET NAMES IN PAREN. SEE THESE NAMES AS APPLICABLE ON DMS PLATS BY MAY PARK & RIDDLETOWN.

617,800

3S 38 4BA