
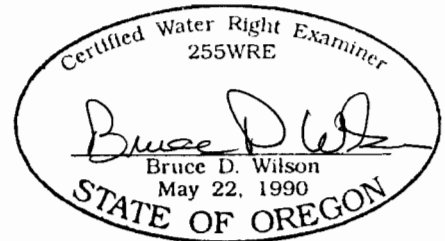
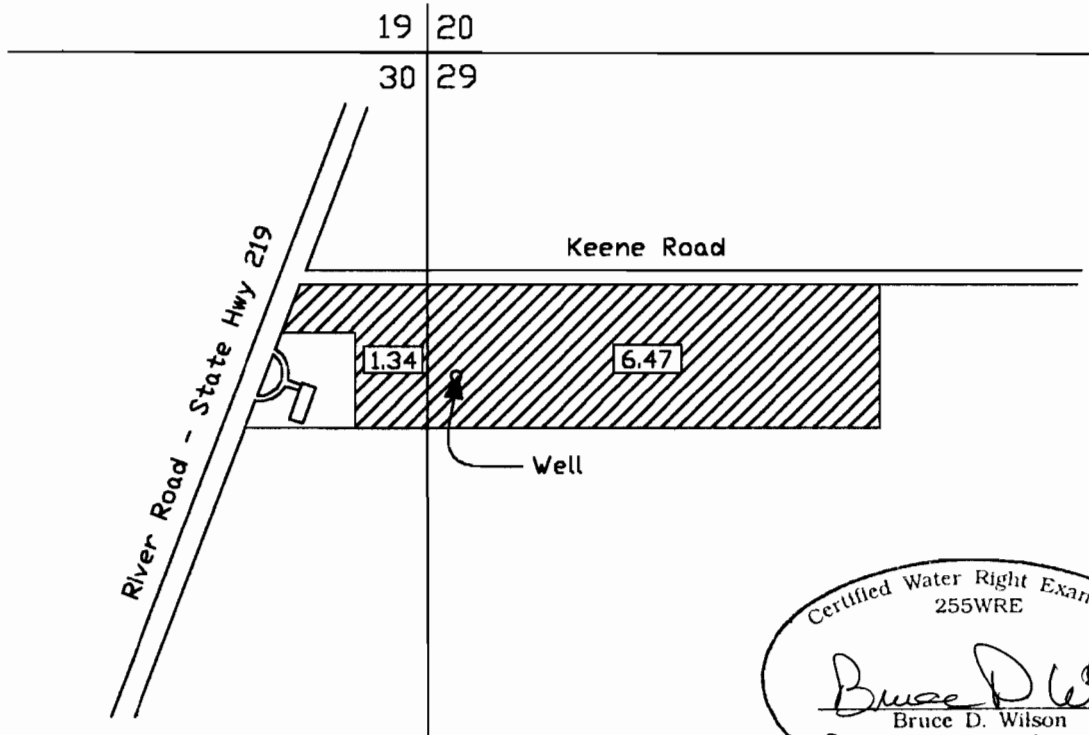


RECEIVED


JAN 29 1997

WATER RESOURCES DEPT.  
SALEM, OREGON

T5S R2W W.M.

 

FLOYD RILEY

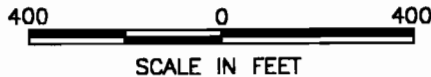

Irrigated Area -

The well is located 60 feet East and 675 feet South from the N.W. corner of section 29.

Application No.         G 14445        

Permit No.         113371