


Township T.11.S  
Range R.4W  
Section 25  
1/4 N.E.

1"-400

Well locations.

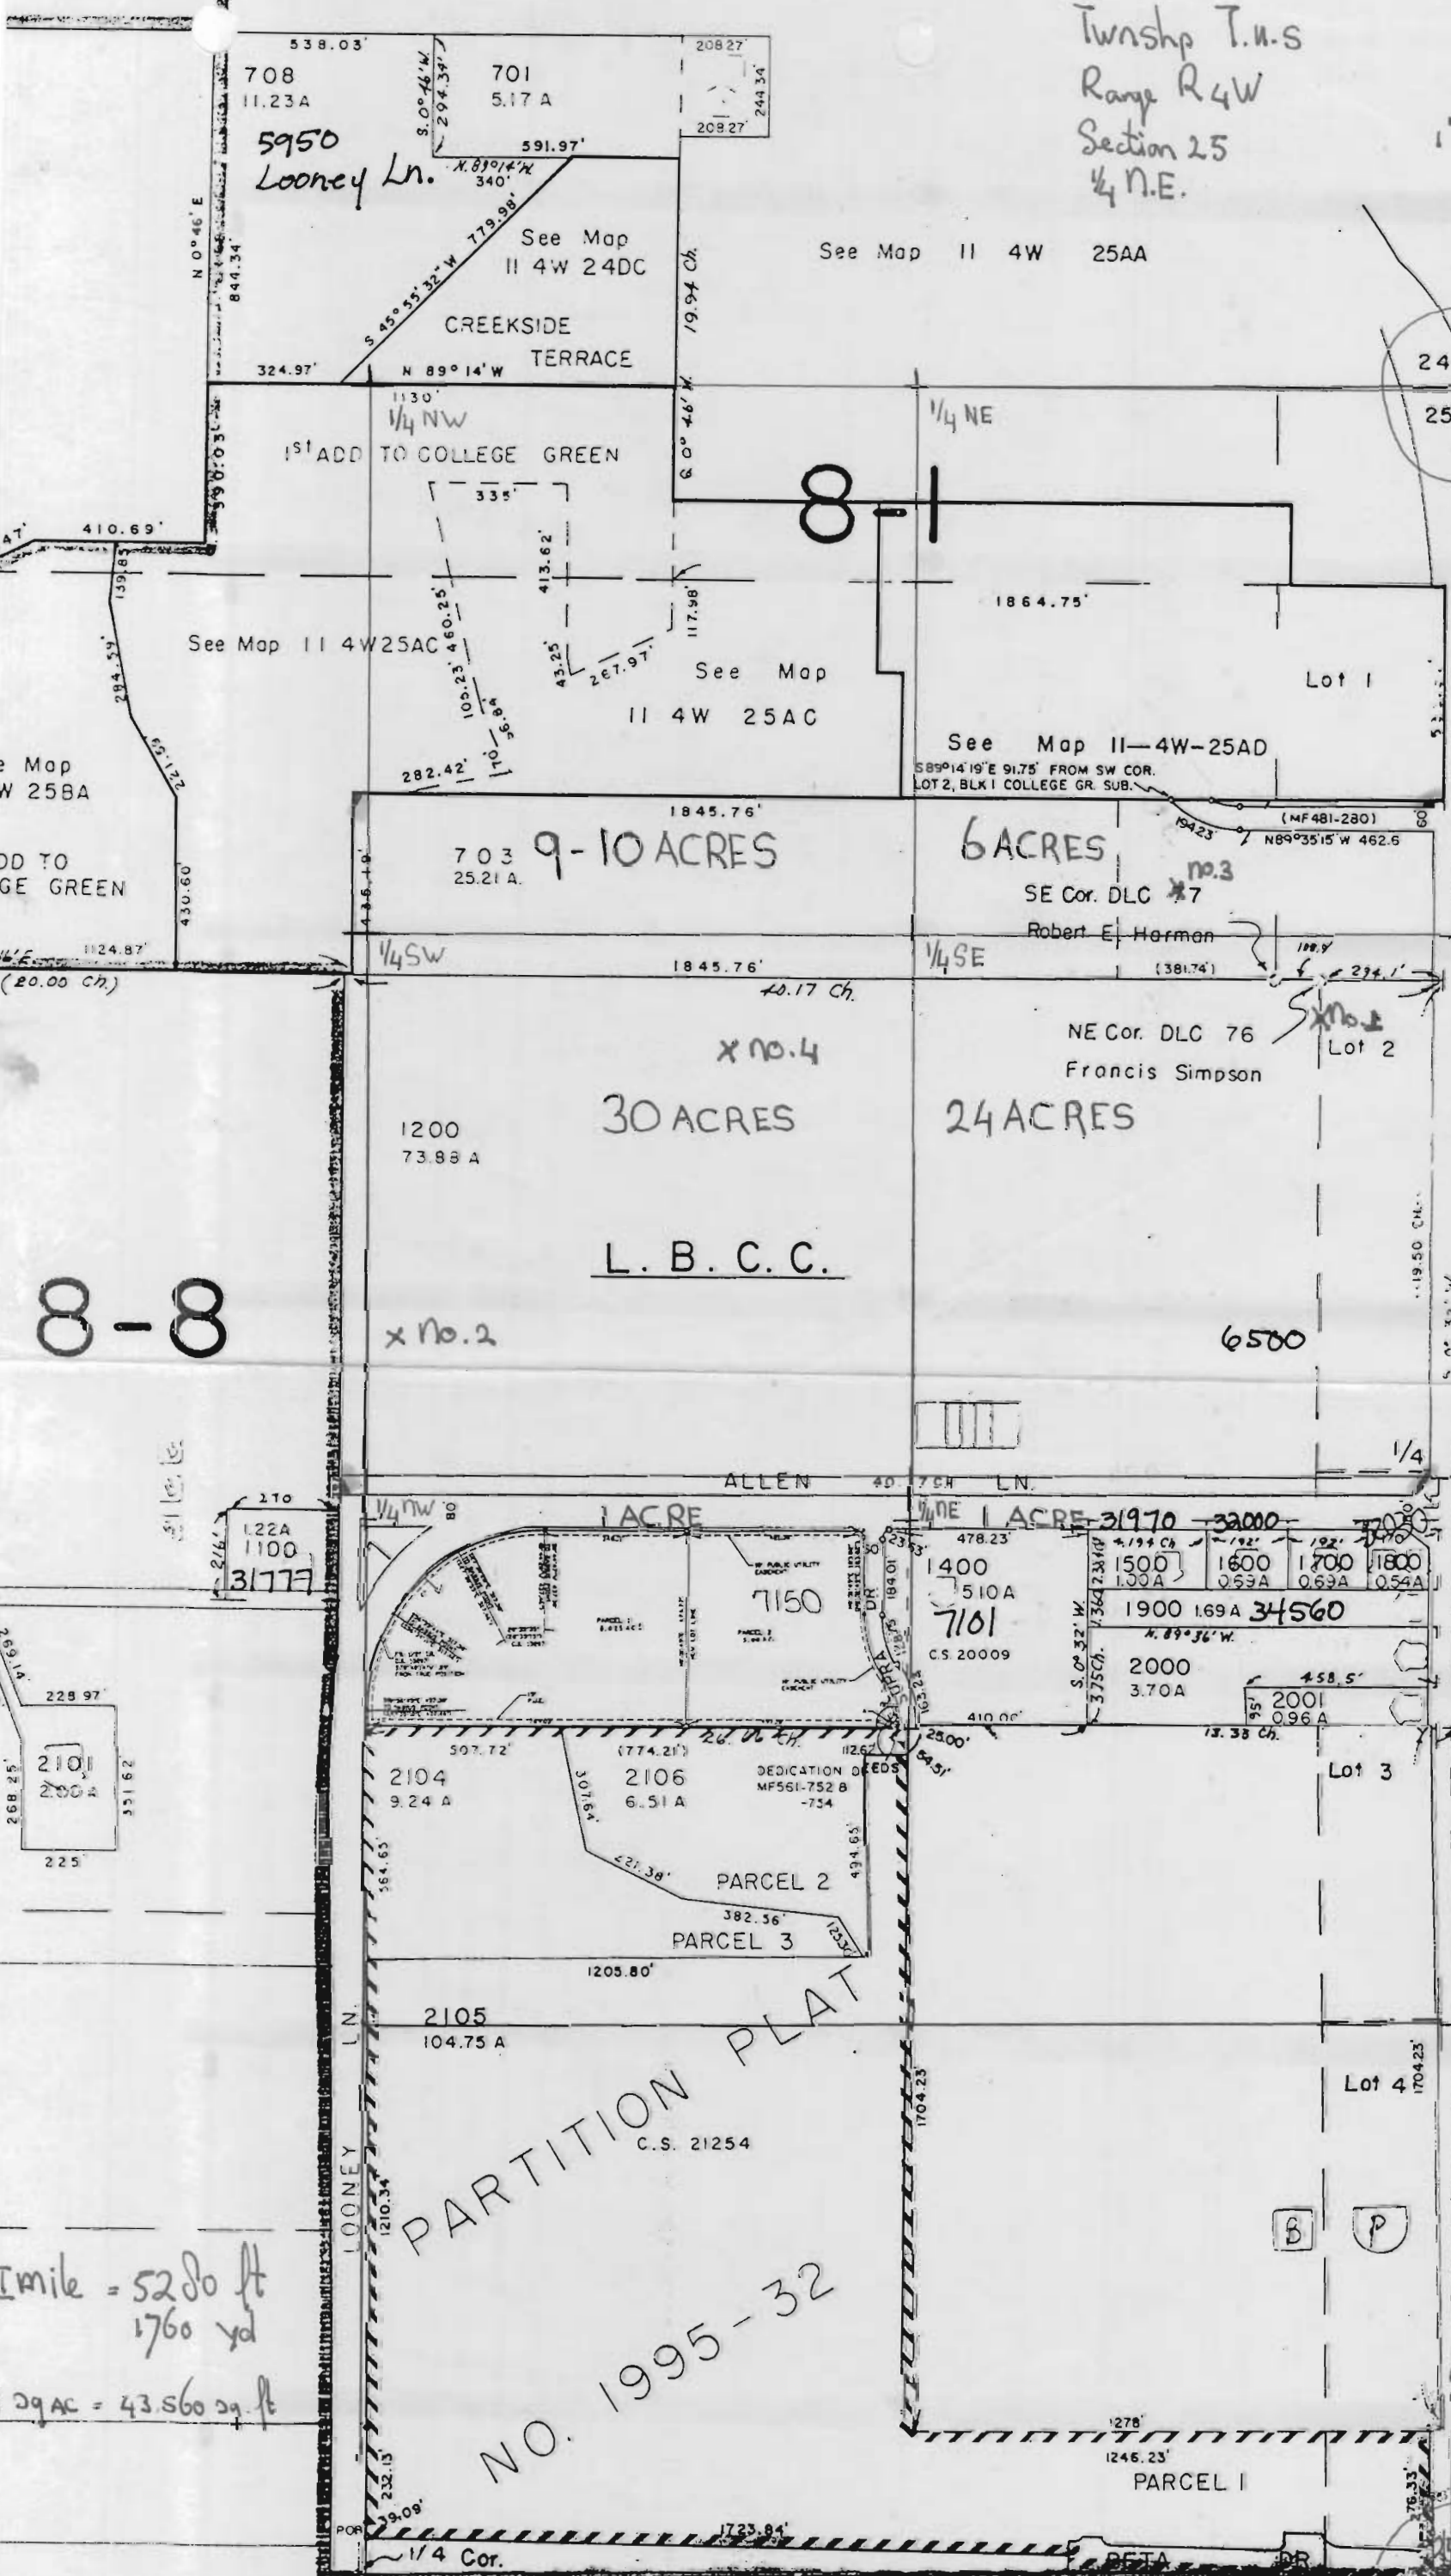

Well no. 1  
NE corner gom  
South 1530 ft  
gom West 345

Well no. 3  
NE corner gom S.  
1220 ft  
gom West 690 feet

Well no. 4  
N.E. corner gom S  
1610 ft  
gom West 1780 ft

Well no. 2  
NE corner gom S  
2320 ft  
gom West 2580

Section 25  
1/4 NE

1/4 NW 10 AC	1/4 NE 6 AC
1/4 SW 30 AC	1/4 SE 24 AC
1/4 NW 1 AC	1/4 NE 1 AC

Section 25  
1/4 SE

Application No. G14438  
Permit No. G13350

1 mile = 5280 ft  
1760 yd  
1 sq AC = 43,560 sq. ft

NO. 1995-32

8-8