


T 5 N, R 26 E, W.M.
SECTION 33

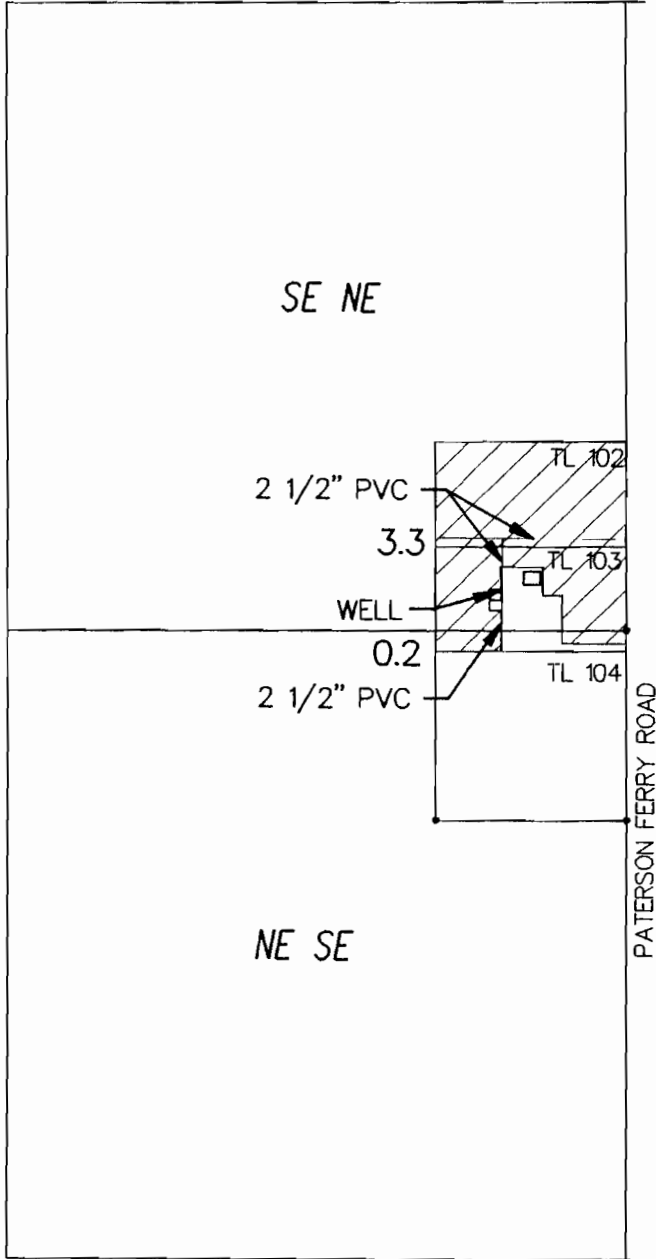

SCALE 1" = 400'


THIS MAP IS FOR IDENTIFYING THE
LOCATION OF WATER RIGHTS ONLY,
AND HAS NO INTENT TO PROVIDE
DIMENSIONS OR LOCATIONS OF
PROPERTY OWNERSHIP LINES.

WELL LOC 80' N & 360' W
FROM THE E 1/4 COR SEC 33.

RECEIVED

NOV 5 2001

WATER RIGHTS DIVISION
STATE OF OREGON

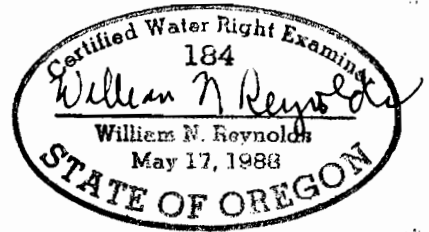

FINAL PROOF SURVEY

UNDER

APPLICATION G-14574 PERMIT G-13404

IN NAME OF

R. GEORGE CAMPBELL

1184FNLP.gcd
OCTOBER, 2001