


KNAPPA WATER ASSOCIATION WELL SOURCE LOCATION MAP

SEC 15, T8N, R7W, W.M.

THE PURPOSE OF THIS MAP IS TO IDENTIFY THE LOCATION OF THE WATER RIGHT. IT IS NOT INTENDED TO PROVIDE INFORMATION RELATIVE TO THE LOCATION OF PROPERTY OWNERSHIP BOUNDARY LINES.

Well No. *G14593*
 Permit No. **G13427**

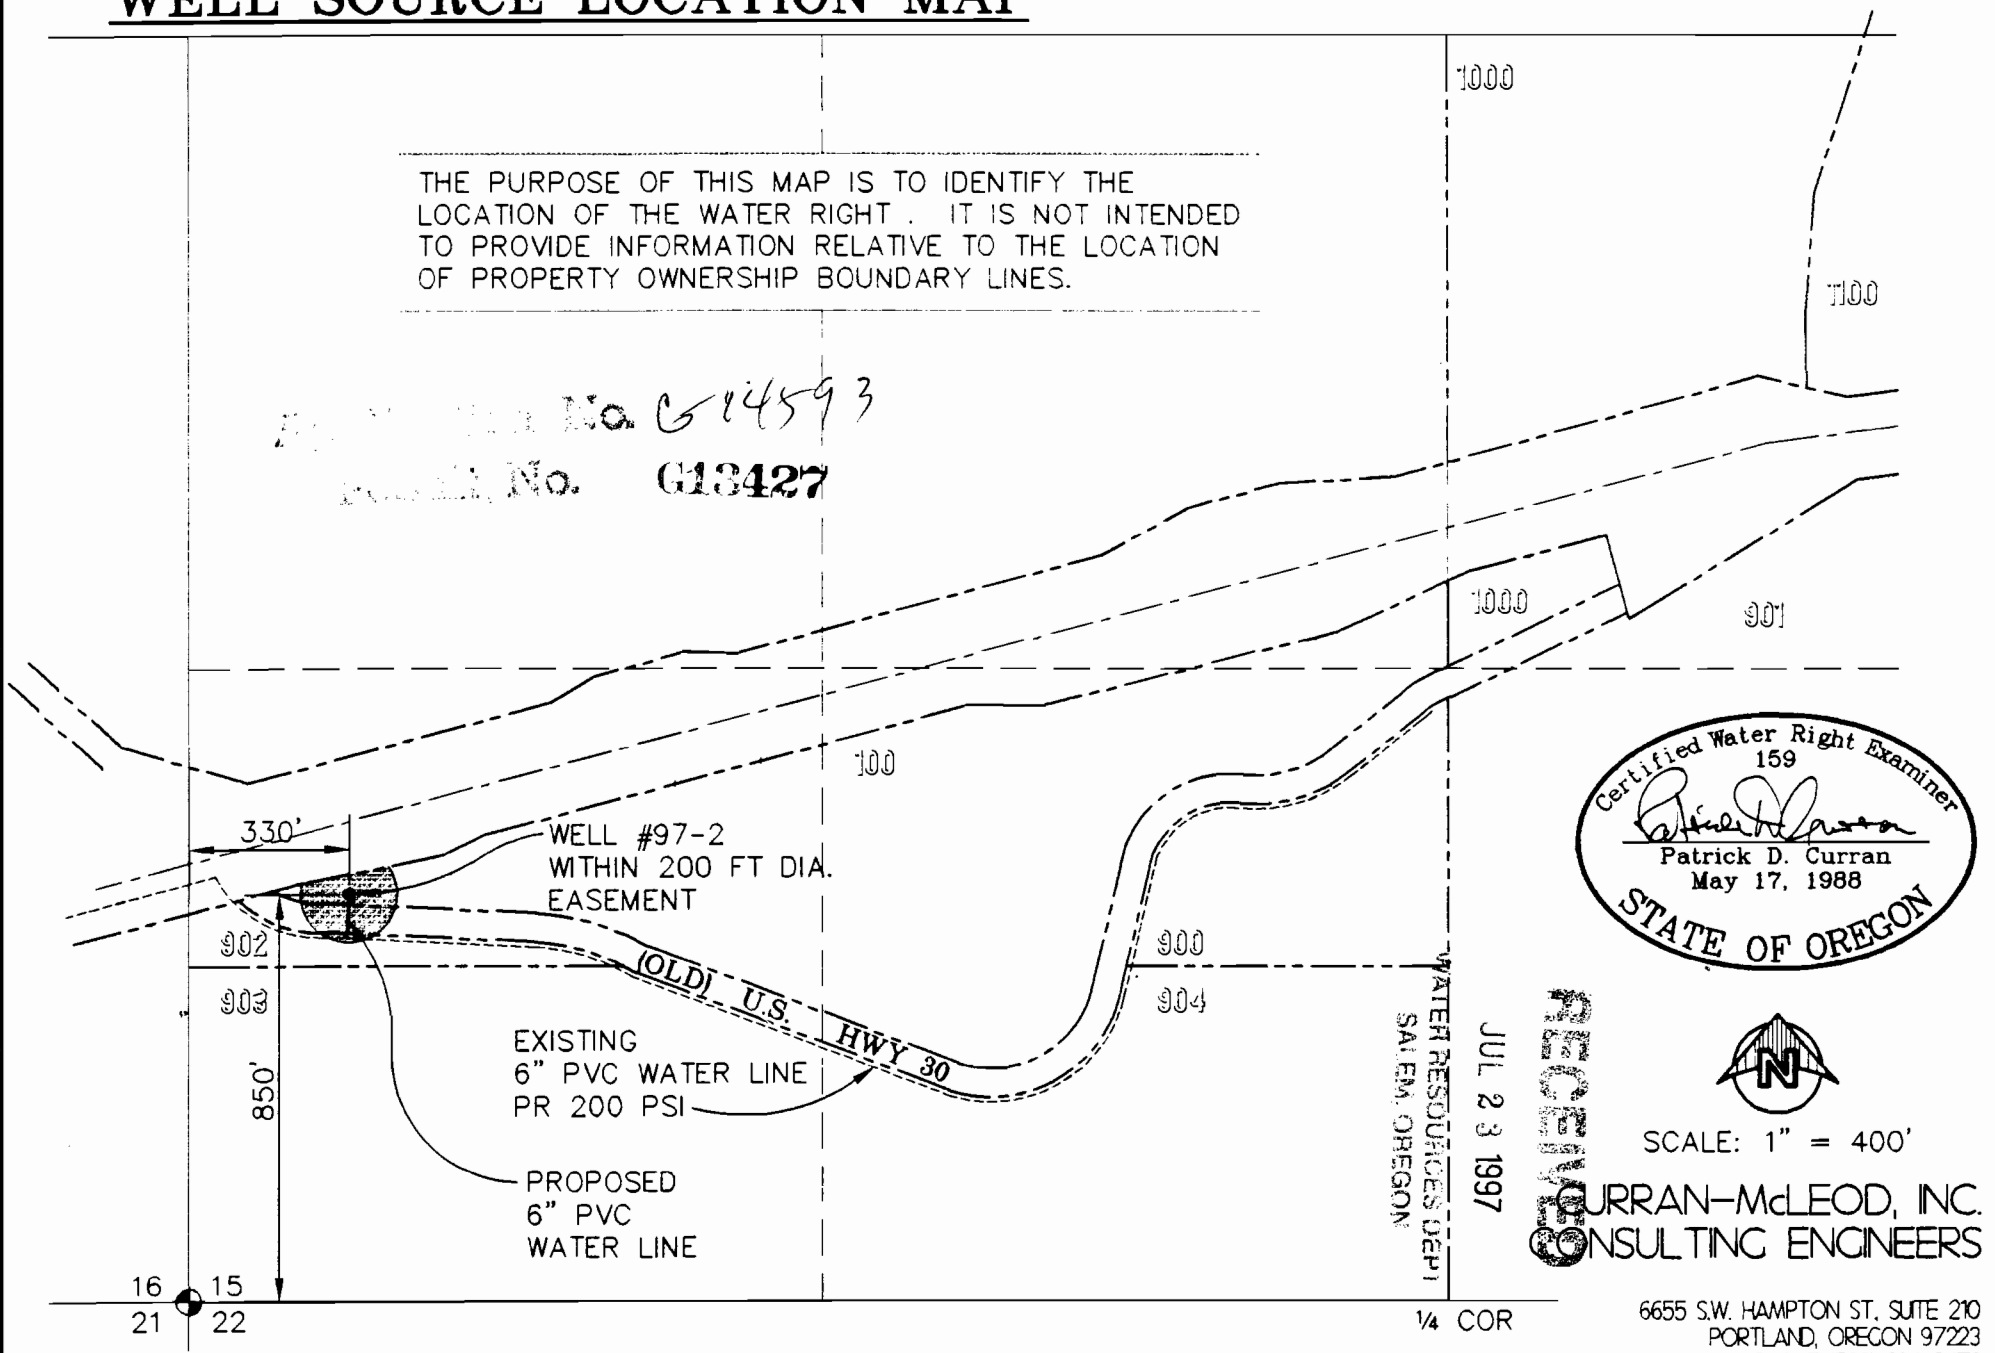

SCALE: 1" = 400'

RECEIVED
 JUL 23 1997
 WATER RESOURCES DEPT
 SALEM, OREGON
CURRAN-McLEOD, INC.
 CONSULTING ENGINEERS

6655 S.W. HAMPTON ST., SUITE 210
 PORTLAND, OREGON 97223
 PHONE (503) 684-3478

1/4 COR