

SCALE 1"=400.

Section 17 T1N R2W WM


RECEIVED

SEP 19 1996

SEE MAP IN 2 8 WATER RESOURCES DEPT. SALEM, OREGON

APP - G14157
PERMIT - G13428

G13331

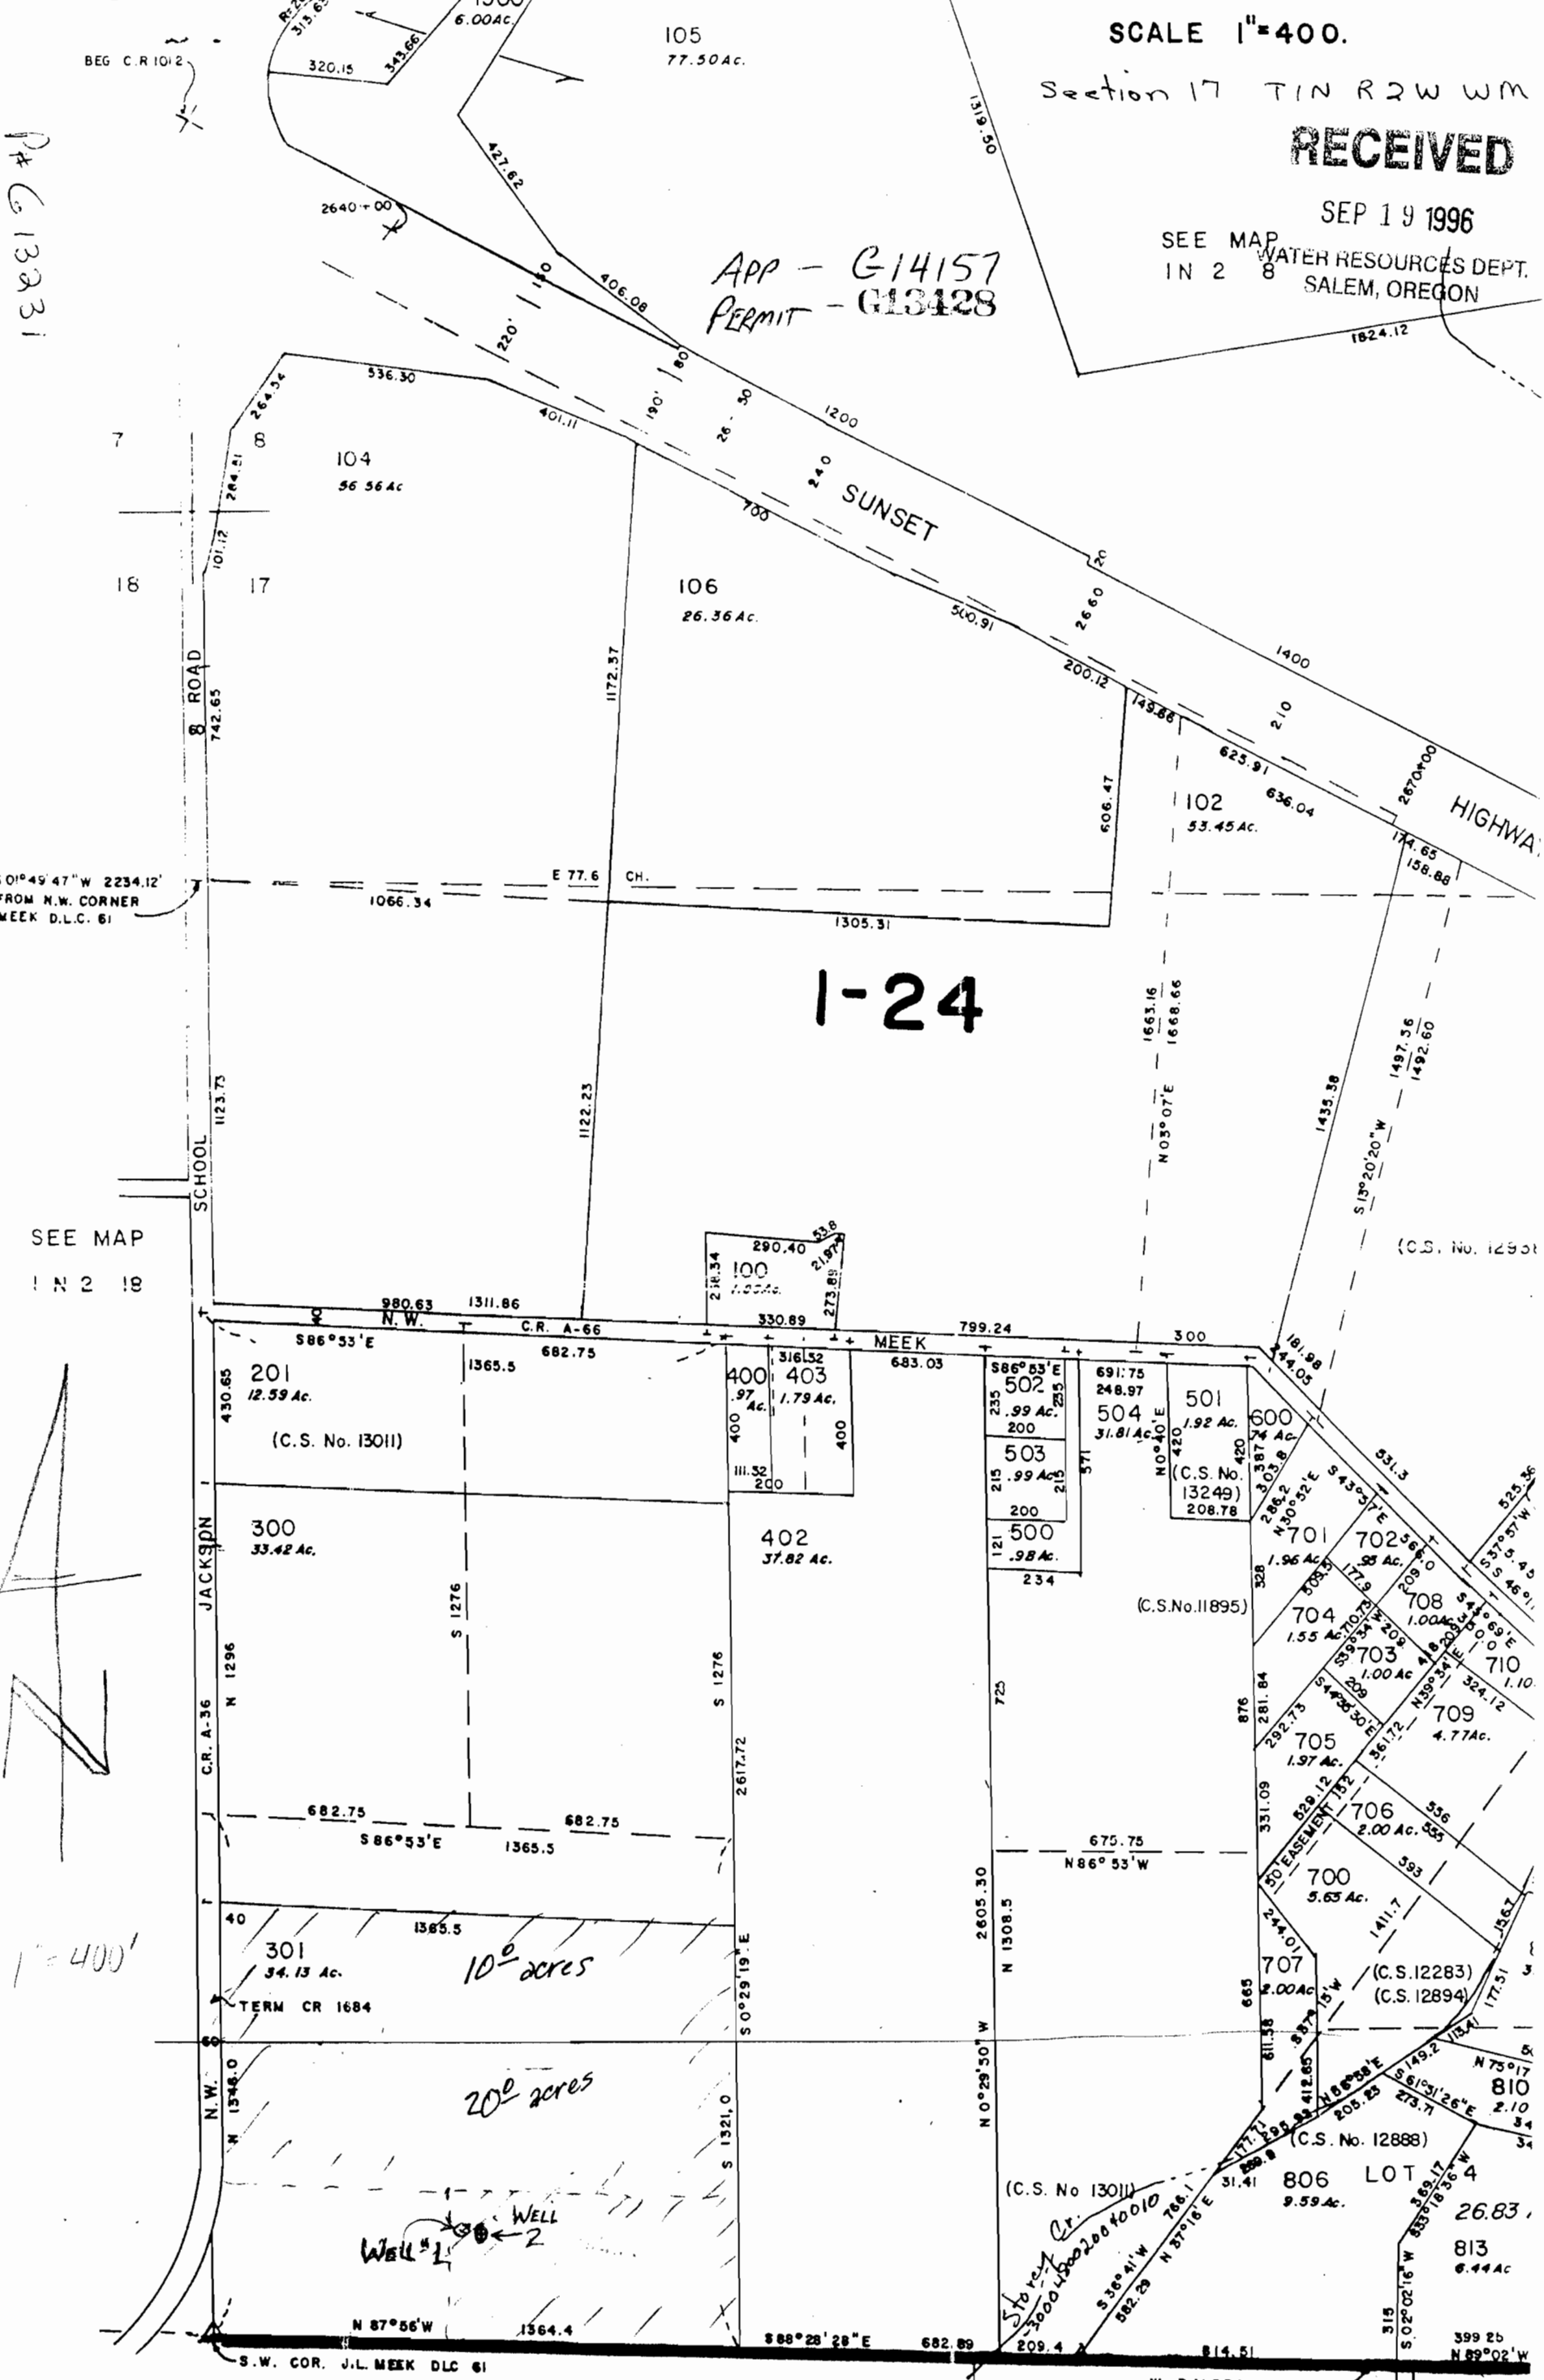

S 01° 49' 47" W 2234.12'
FROM N.W. CORNER
MEEK D.L.C. 61

SEE MAP
IN 2 18



1"=400'

10⁰ acres

20⁰ acres

WELL #1
WELL #2

Well #1 - 300 ft. North & 650' East
 Well #2 - 300 ft. North & 700' East
 - both from the SW Cor. Meek
 D.L.C. 61

SEE MAP
IN 2 20

7.

S 01° 20' E
6.19 CH

N 89° C