

LEGEND

LINE TYPES

- TAX LOT BOUNDARIES
- OLD PROPERTY LINES
- RIVERS, LAKES, ETC.
- CREEKS, POND, ETC.
- RAILROADS
- TAX CODE BOUNDARIES
- SUBDIVISION BOUNDARIES

SYMBOL TYPES

- CONTROL POINTS
- SURVEY MONUMENTS
- G.L.O. CORNERS (APPROX) (FOUND)
- SECTION
- 1/4 SEC
- 1/16 SEC
- D.L.C.


OREGON STATE PLANE COORDINATE SYSTEM GRID MARKS - NAD 27

NUMBERS

TAX CODE NO. 000 00 00 0


ACREAGE - ALL ACREAGES EXCLUDE ANY PORTION THAT MAY LIE WITHIN THE INDICATED PUBLIC RIGHT OF WAYS.

TICK MARKS - WHEN A TICK MARK IS INDICATED ON THE EXTENSION OF A LINE, THEN THE DIMENSION GOES TO THE TICK MARK. GENERALLY THIS IS USED WHEN DIMENSIONS GO INTO PUBLIC RIGHT OF WAYS.

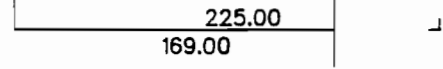

ARROWS ARE USED WITH DIMENSIONS IN AREAS OF GREATER COMPLEXITY.

WARNING: This map was created by digitizing assorted existing maps. NO Research was done. Created for Assessor's Office use ONLY.

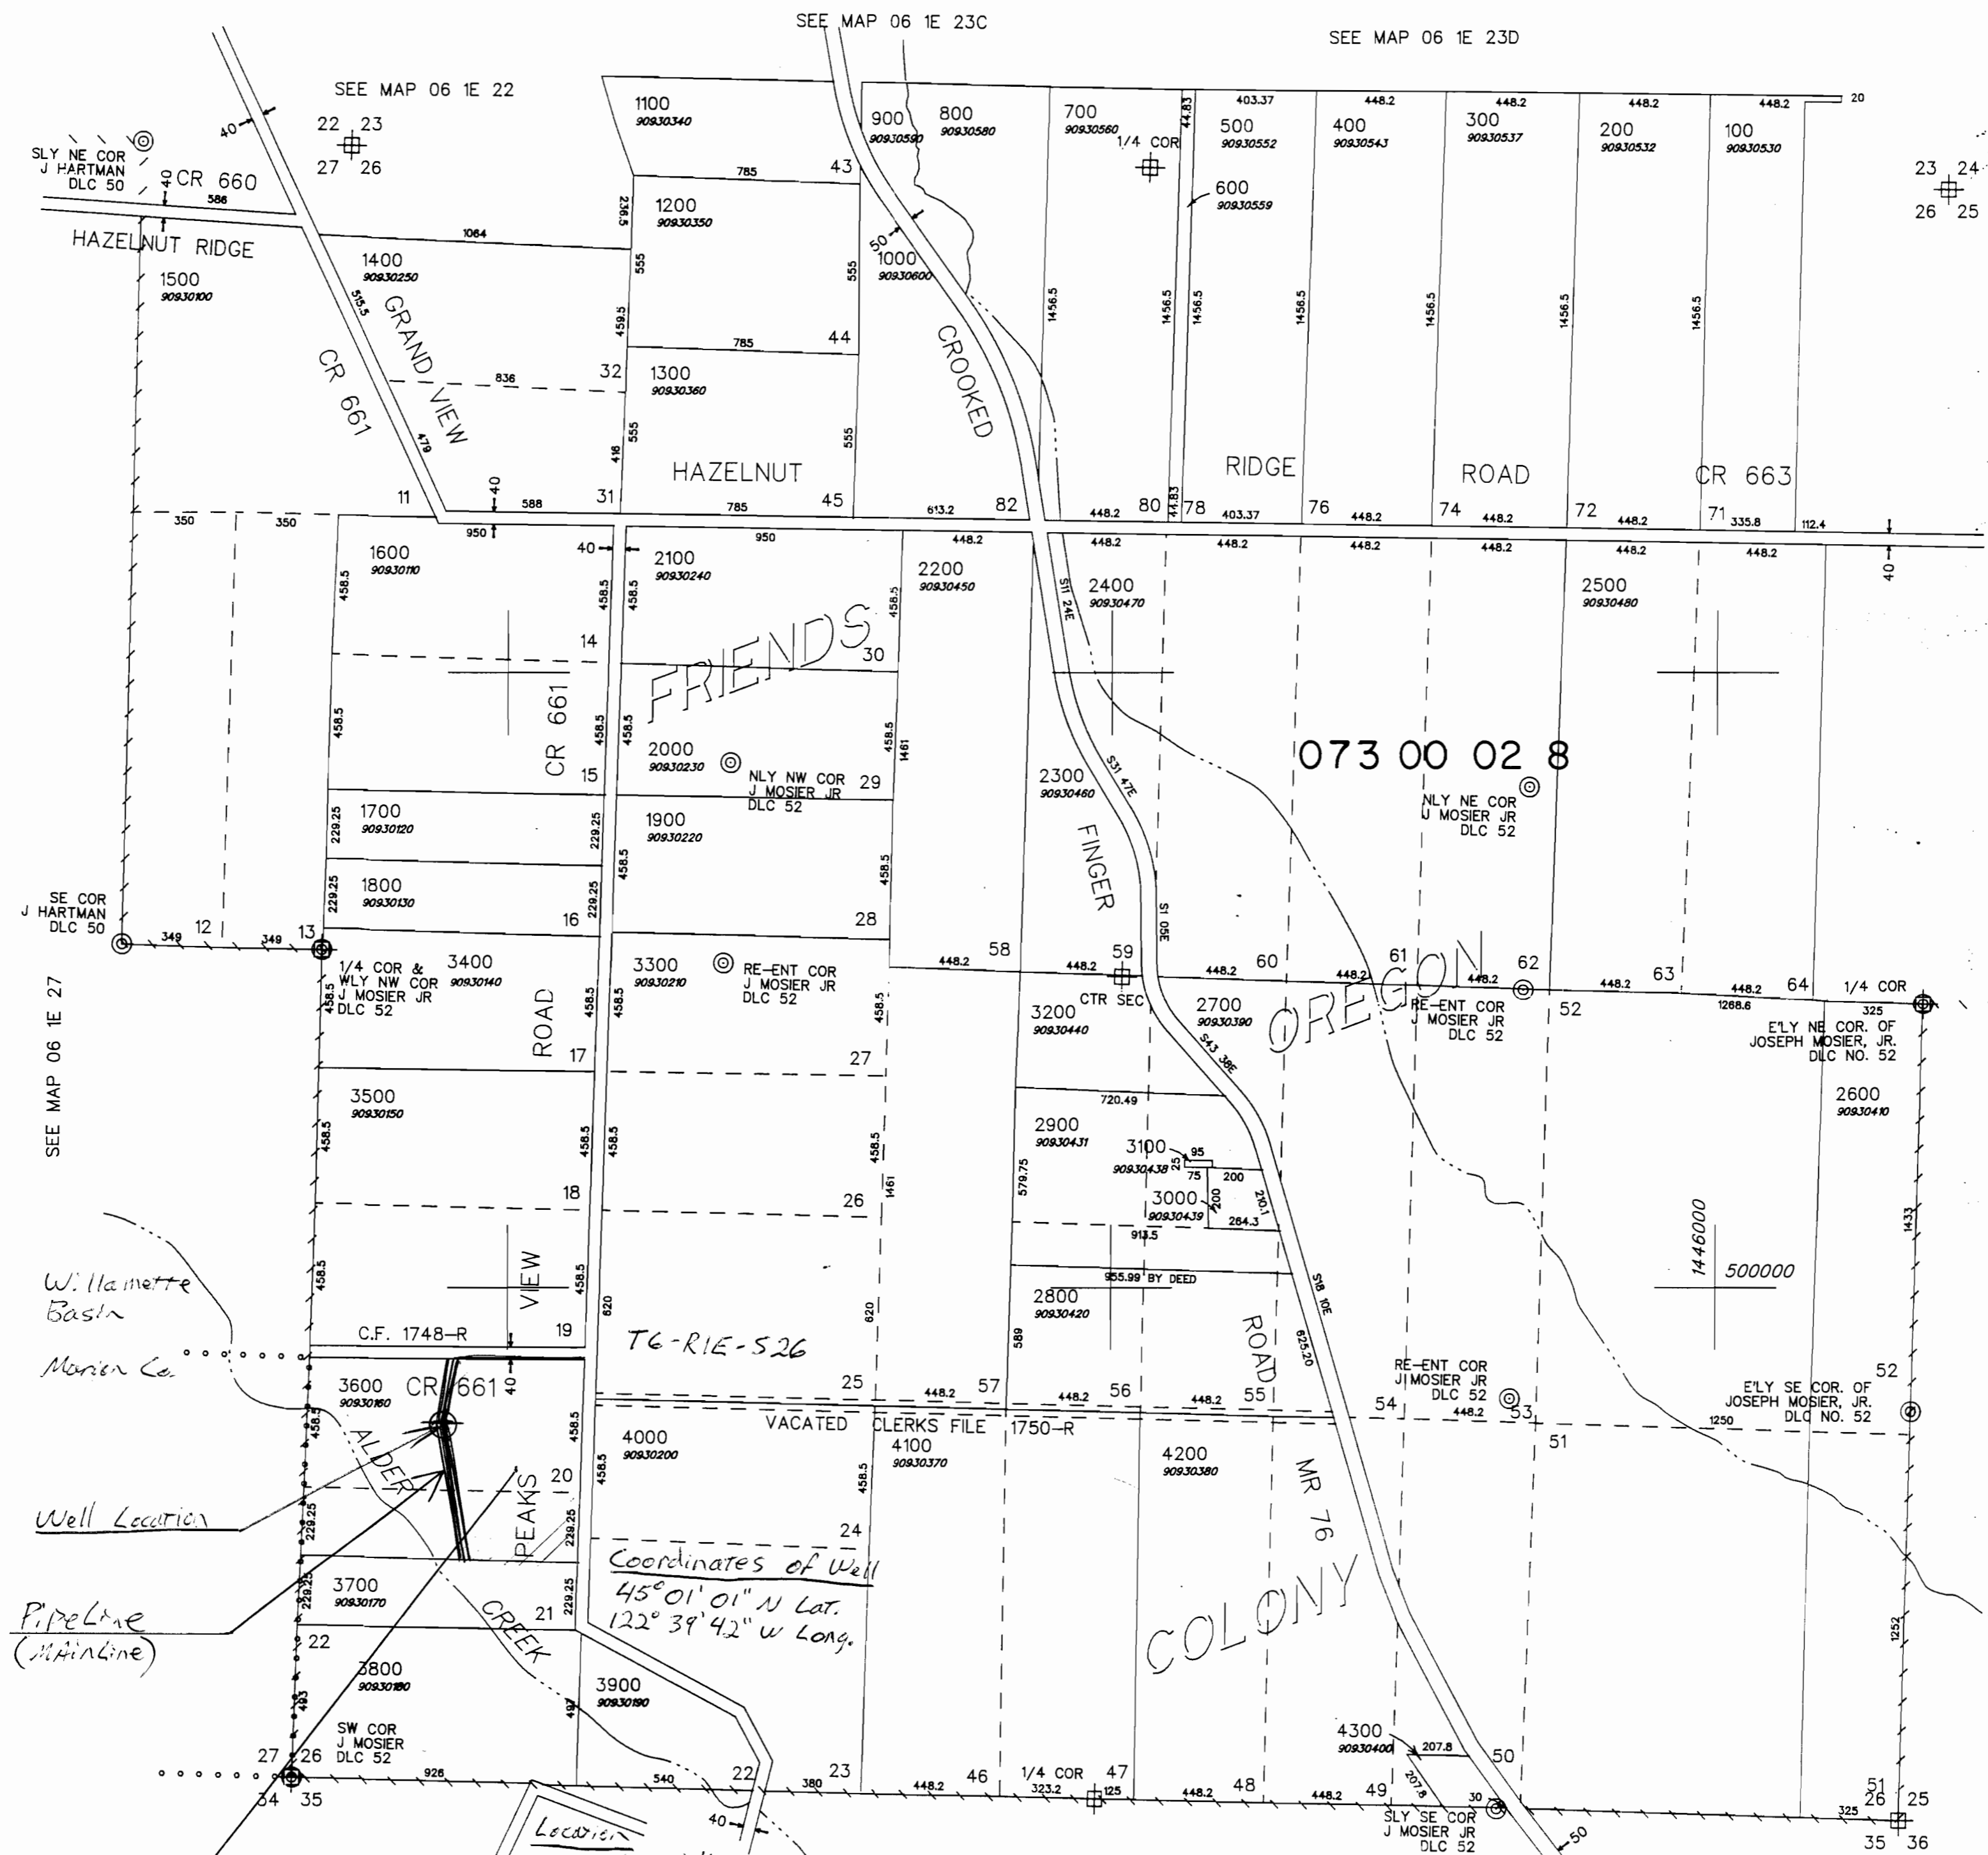

RECEIVED FEB 19 1997 WATER RESOURCES DEPT SALEM, OREGON



1" = 400' 03-JAN-91

SEE MAP 06 1E 25

Location Lot 20 and North 1/2 Lot 21 Friends Oregon Colony Marion Co. OR. Vol. 3 Pg 52 Record of Town Plats For Marion Co. Account #90930-160

Irrigated Area 8 Ac MAX.

G 14459 013434