RECEIVED
MAR 11 1998
WATER RESOURCES DEPT.
SALEM, OREGON

Application Map for Frank Conklin T15S, R10E, Section 4

Tax Lot 1101 in the SE1/4 of the NW1/4 and NE1/4 of the SW1/4. Well is 80' North and 300' West of the Center of Section 4, T15S, R10E.

Scale 1" = 400'

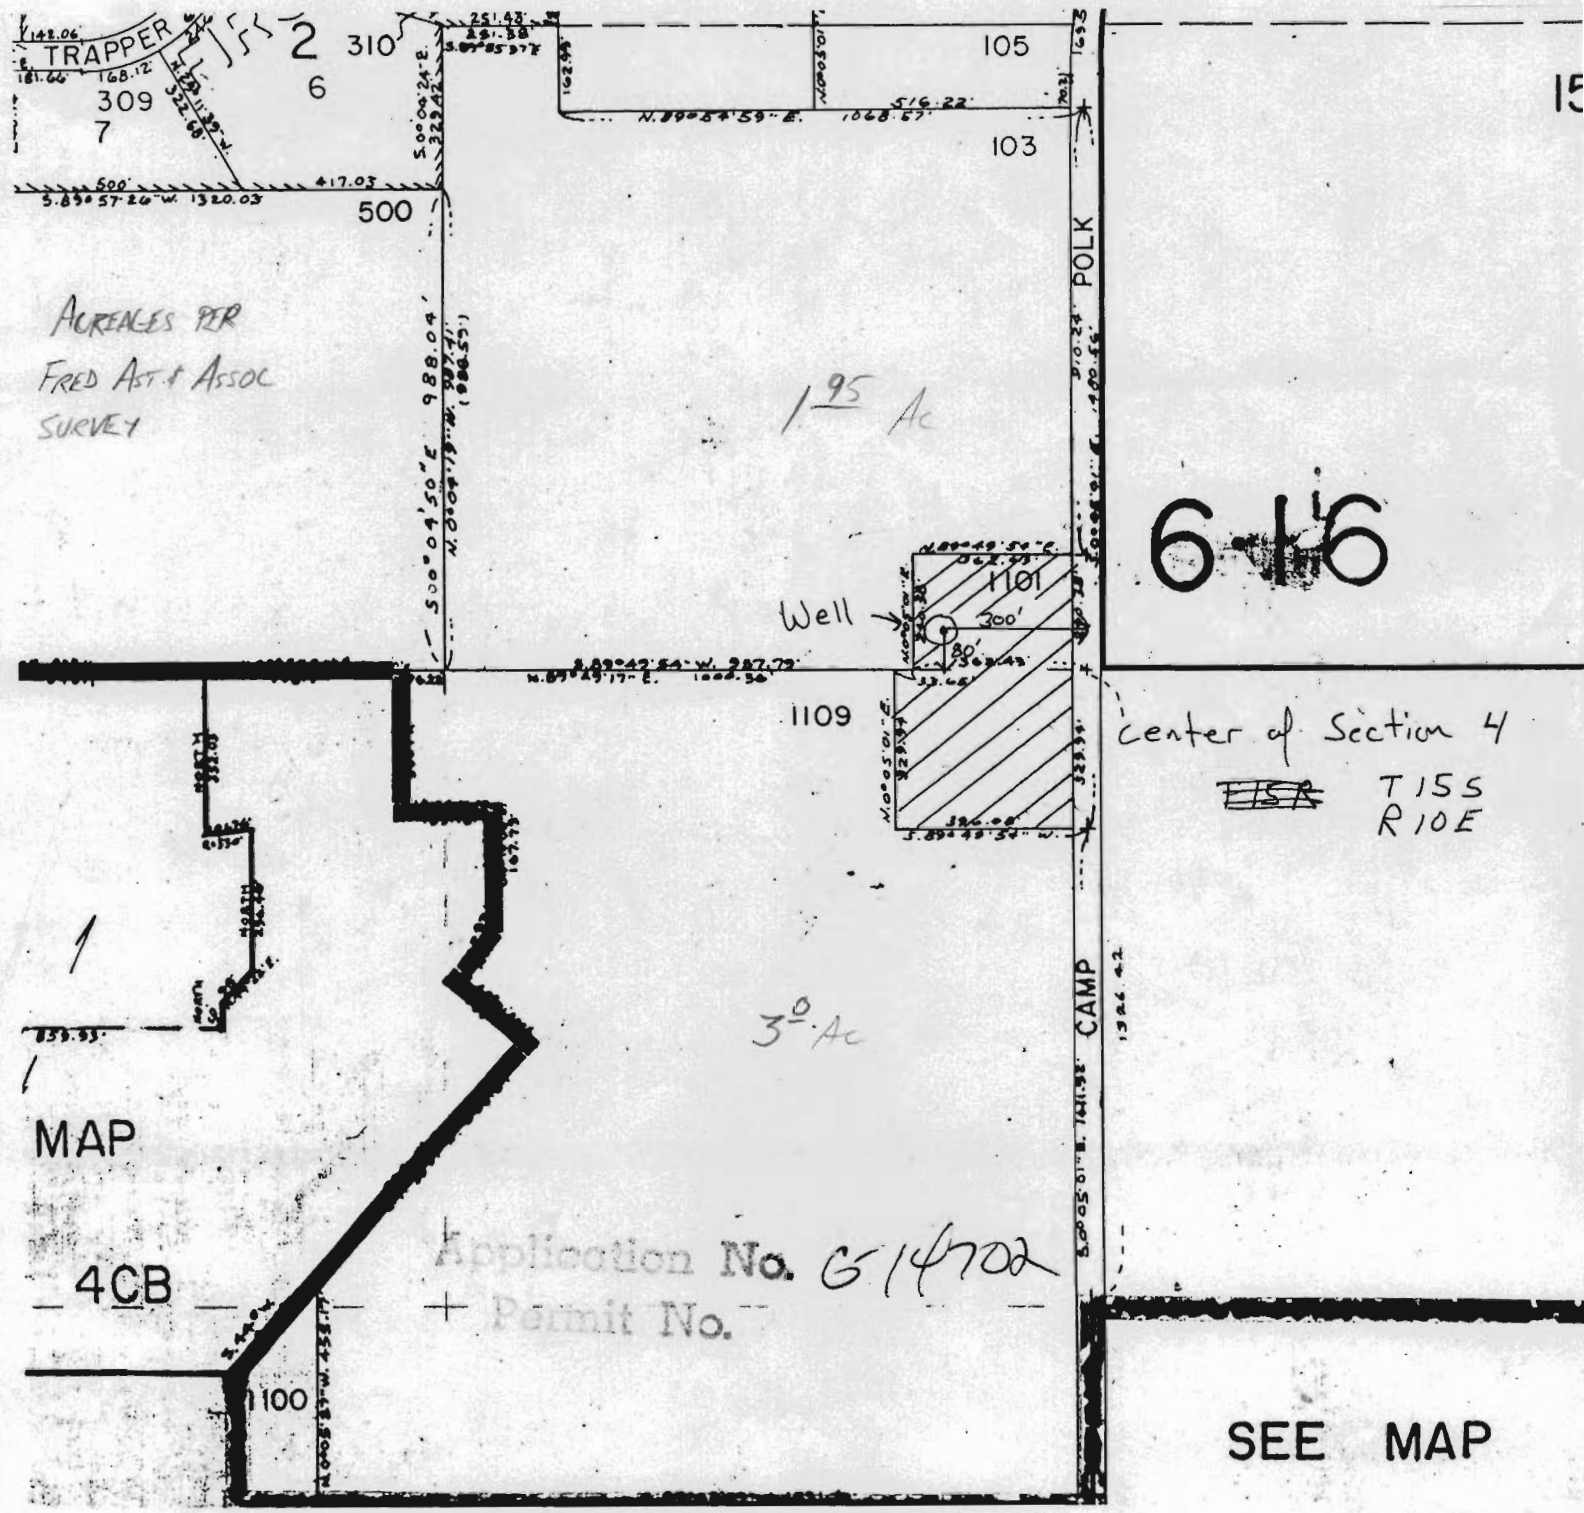

Application No. G14702
Permit No.