


**TOWNSHIP 1 NORTH, RANGE 3 EAST, W.M.
SECTIONS 28 AND 29**

LEGEND

- EXISTING QUARTER SECTION LINES
- EXISTING SIXTEENTH LINE
- - - - - APPROXIMATE PROPERTY BOUNDARY
- LOT LINES
- 2-INCH-DIAMETER WATER LINE
- POINT OF APPROPRIATION (WELL)
- APPROXIMATE MOBILE HOME LOCATION

WELL LOCATED 950' N. AND 20' E. OF SW CORNER OF NW1/4 OF SECTION 28

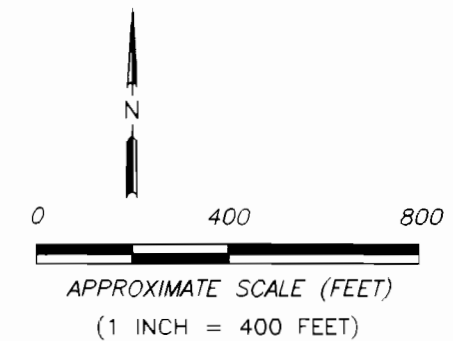

RECEIVED

Aug 11 2000

WATER RESOURCE DIV
SALEM OREGON

THIS MAP WAS PREPARED FOR THE PURPOSE OF IDENTIFYING THE LOCATION OF WATER RIGHTS ONLY AND IS NOT INTENDED TO PROVIDE LEGAL DIMENSIONS OR LOCATIONS OF PROPERTY OWNERSHIP LINES.

SECOR
International Incorporated
015

CLAIM OF BENEFICIAL USE MAP
JOHN M. SIMPSON
SANDY BOULEVARD MOBILE VILLA
APPLICATION G-14598, PERMIT G-13454
JUNE 7 & 9, 2000

FIGURE:

1

JOB#: 015.08728.500 APPR: DWN: KPM DATE: 8/20/00