


RECEIVED

JUN 17 1997

WATER RESOURCES DEPT.  
SALEM, OREGON

# TOWNSHIP 1 SOUTH, RANGE 4 EAST, W.M.

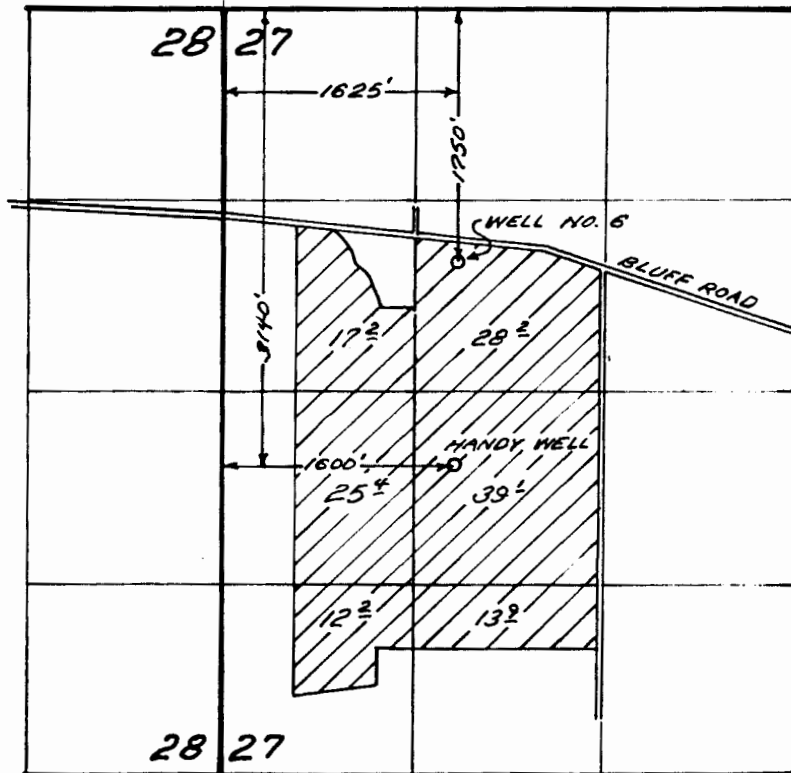

Handy well  
dropped from  
applic  
5/27/98  
H.S.

APPL. No. G-14569  
PER. No. G-13469

APPLICATION MAP  
FOR

J. FRANK SCHMIDT & SON CO.

Application No. G-14569  
Permit No. G13469

THIS MAP WAS PREPARED FOR THE PURPOSE OF IDENTIFYING THE LOCATION OF A WATER RIGHT ONLY AND IS NOT INTENDED TO PROVIDE LEGAL DIMENSIONS OR LOCATION OF PROPERTY OWNERSHIP LINES.