

SW1/4 SE1/4 SEC.08 TWP.5S. RGE.1W. WM
MARION COUNTY, OREGON

5 1W 08DC
WOODBURN

CANCELLED NUMBERS
6200

SEE MAP 05 1W 08DB

LEGEND

LINE TYPES

- TAX LOT BOUNDARIES
- OLD PROPERTY LINES
- RIVERS, LAKES, ETC.
- CREEKS, POND, ETC.
- RAILROADS
- TAX CODE BOUNDARIES
- SUBDIVISION BOUNDARIES

SYMBOL TYPES

- CONTROL POINTS
- SURVEY MONUMENTS
- G.L.O. CORNERS (APPROX) (FOUND)
- SECTION
- 1/4 SEC
- 1/16 SEC
- D.L.C.


OREGON STATE PLANE
COORDINATE SYSTEM
GRID MARKS - NAD 27

NUMBERS

TAX CODE NO.
000 00 00 0


ACREAGE - ALL ACREAGES EXCLUDE
ANY PORTION THAT MAY LIE
WITHIN THE INDICATED PUBLIC
RIGHT OF WAYS.

TICK MARKS - WHEN A TICK MARK IS
INDICATED ON THE EXTENSION OF
A LINE, THEN THE DIMENSION GOES
TO THE TICK MARK. GENERALLY THIS
IS USED WHEN DIMENSIONS GO INTO
PUBLIC RIGHT OF WAYS.

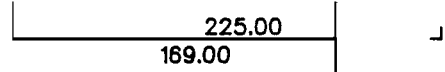

ARROWS ARE USED WITH DIMENSIONS
IN AREAS OF GREATER COMPLEXITY.

**WARNING: This map was
created by digitizing
assorted existing maps.
NO Research was done.
Created for Assessor's
Office use ONLY.**

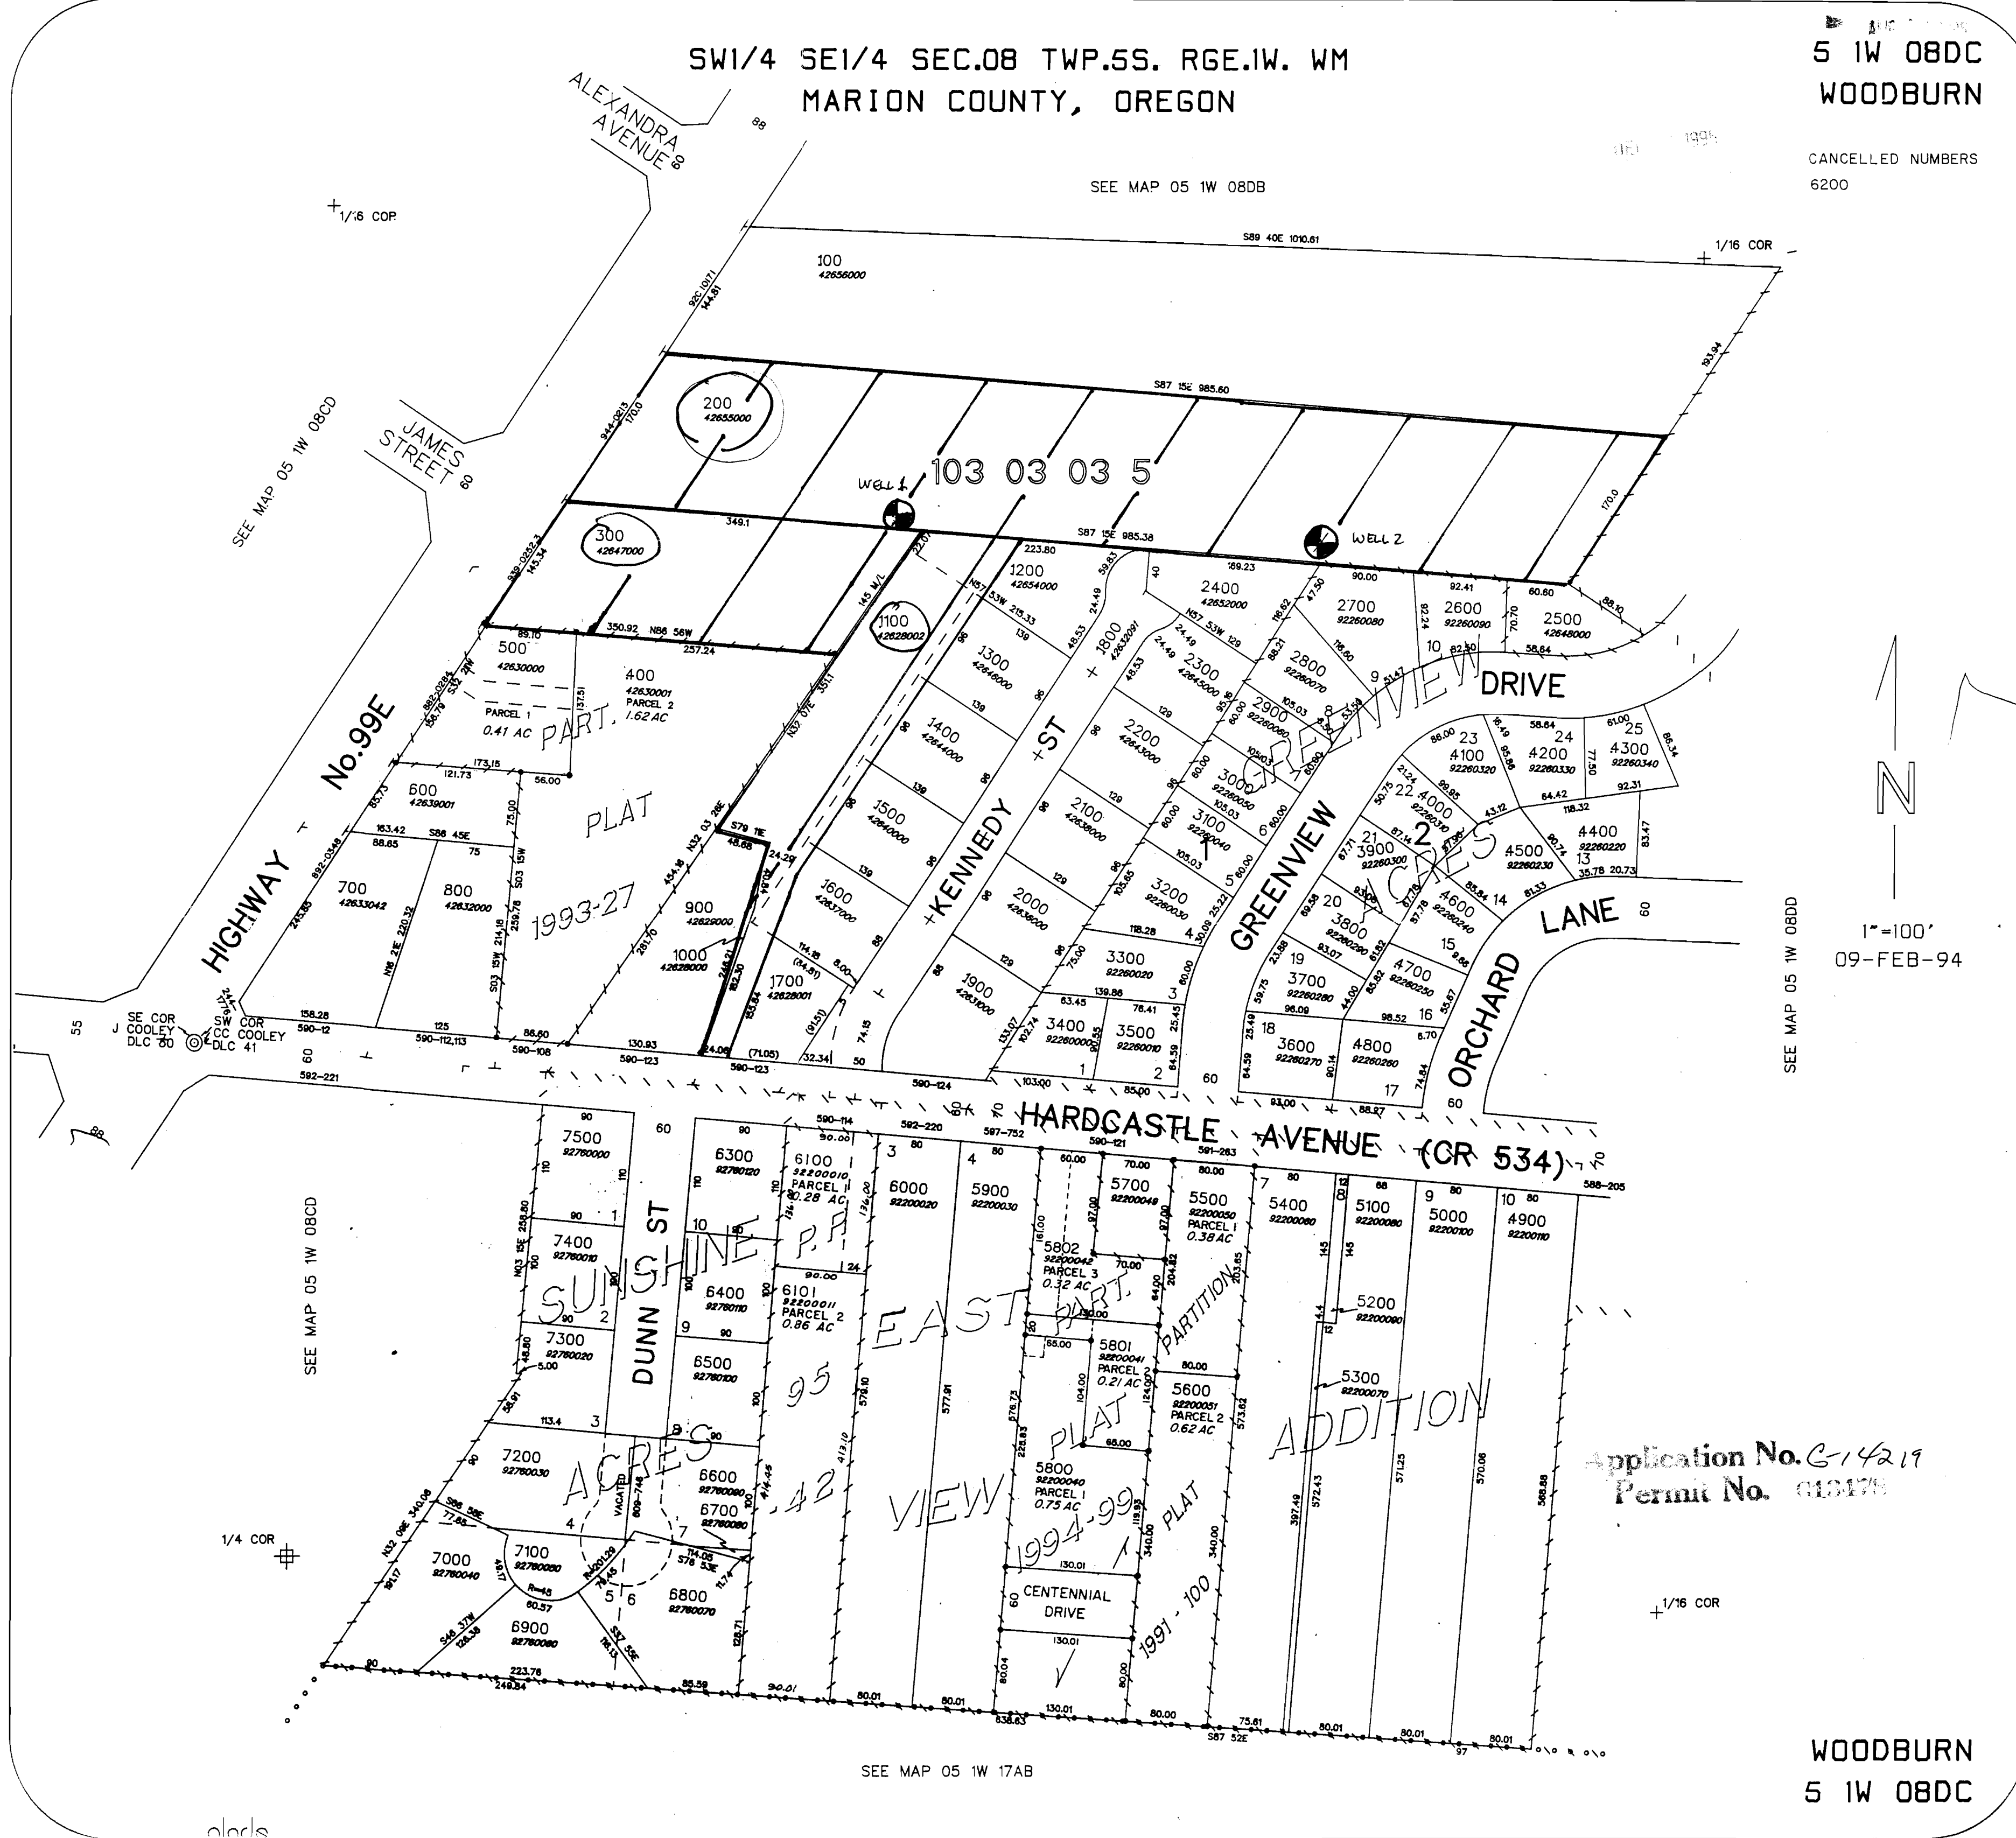

1"=100'
09-FEB-94

Application No. G-14219
Permit No. 010176

SEE MAP 05 1W 17AB