

T. 4N., R. 29E., W.M.

UMATILLA COUNTY

SCALE 1" = 400'

Tax Lot 5100

Application #G-14617
Permit #G-13481



2.15 Acres

Well

675'

645'

HIGHWAY NO. 207

Baxter Road

Reed Road

Well Located 645 Ft. North and 675 Ft. West of the Center Quarter Corner
of Section 6, Township 4 North, Range 29 East, W.M., SE 1/4 of the NW 1/4
WGS84 - N 45° 51' 30.089", W 119° 14' 19.690"

WATER RIGHTS PROOF MAP




Water Use Found at This Location

IN NAME OF

PAUL E. HENDERSON

THIS MAP IS FOR THE PURPOSE
OF IDENTIFYING THE LOCATION
OF WATER RIGHTS ONLY AND IS
NOT INTENDED TO PROVIDE THE
LEGAL DIMENSIONS OR LOCATIONS
OF PROPERTY OWNERSHIP LINES.

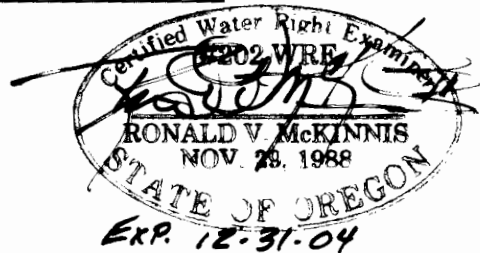

RECEIVED
SEP 29 2003
WATER RESOURCES DEPT
SALEM, OREGON

ENGINEERING - LAND SURVEYING - WATER RIGHTS
R. V. McKINNIS ENGINEERING
79980 Prindle Loop Road
Hermiston, Oregon 97838
(541) -567-2017

