


T23 S, R 30 E, WM

26

25

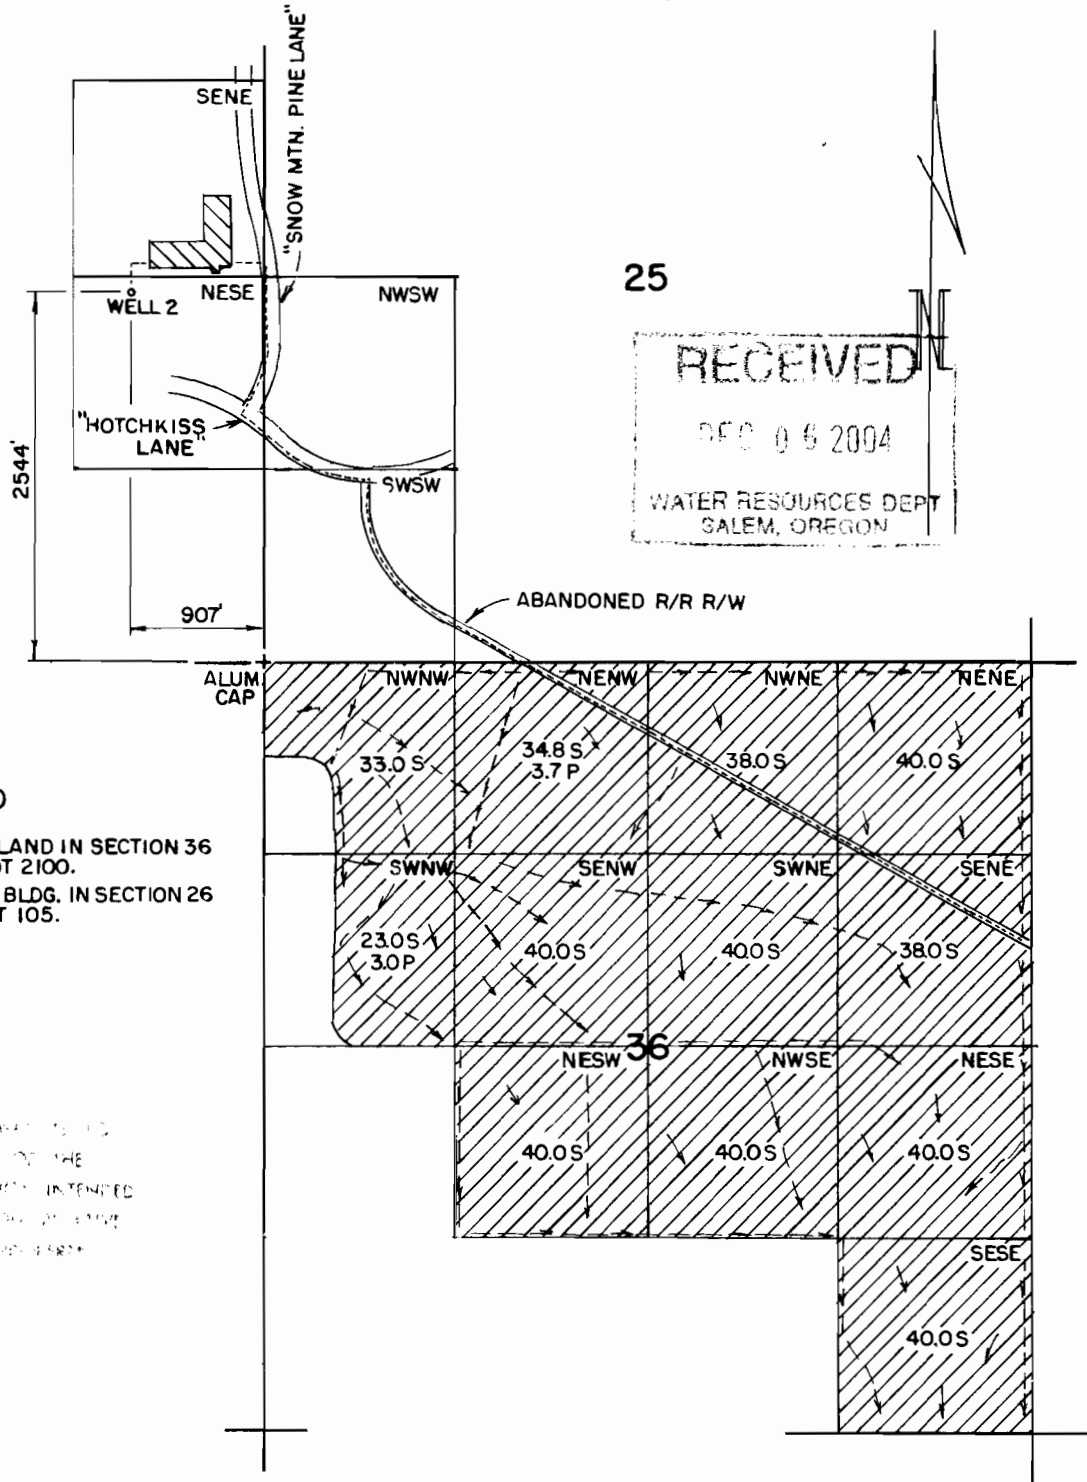

LEGEND

- IRRIGATED LAND IN SECTION 36 IS IN TAX LOT 2100.
- INDUSTRIAL BLDG. IN SECTION 26 IS IN TAX LOT 105.


FINAL PROOF SURVEY

UNDER APPLICATION G-14645
PERMIT G-13485

IN THE NAME OF
MONACO COACH CORPORATION,
WILLIAM & LORI PEILA

Scale: 4" = 1 MILE

Date: NOV. 2004

Job: 2200

Dsn:

Drn: CHRIS


Ckd:



M.A. PALMER & SONS, INC.
ENGINEERING & SURVEYING
711 Ponderosa Village • Box 61
Burns, Oregon 97720

Sht. No.

of 1

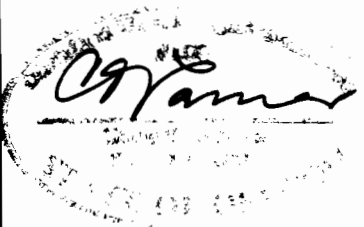

RENEW 1-1-2005