


G 10665
D-13458



T.5N. R.36E. W.M.

FROM
V 1/2
SEC. 18

TO
V 1/2
SEC. 18

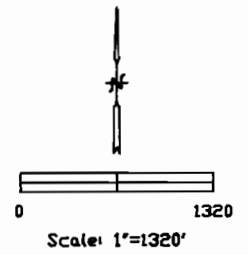


Revised: 8/11/97

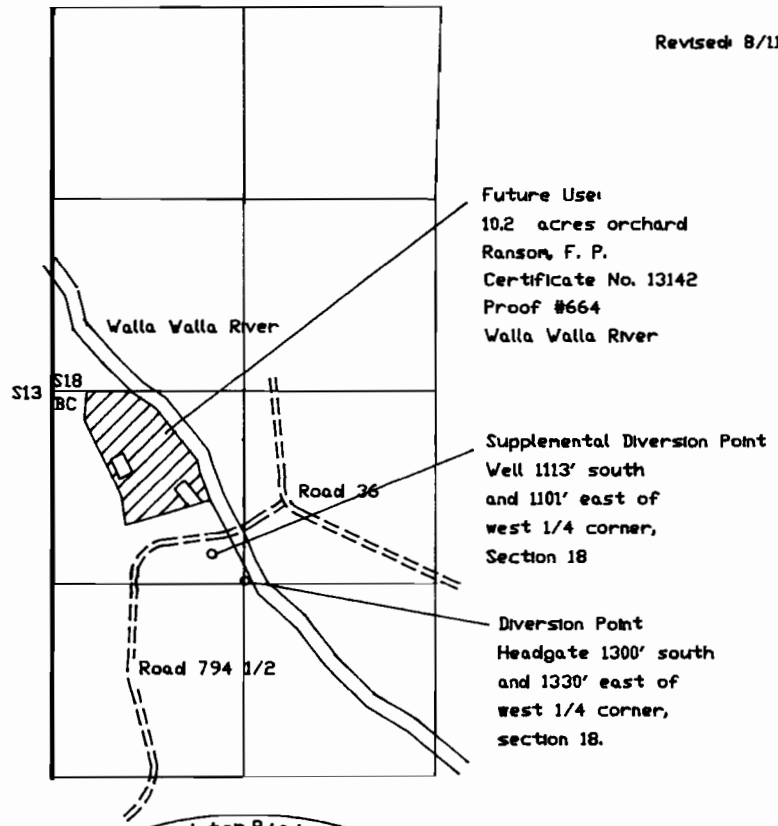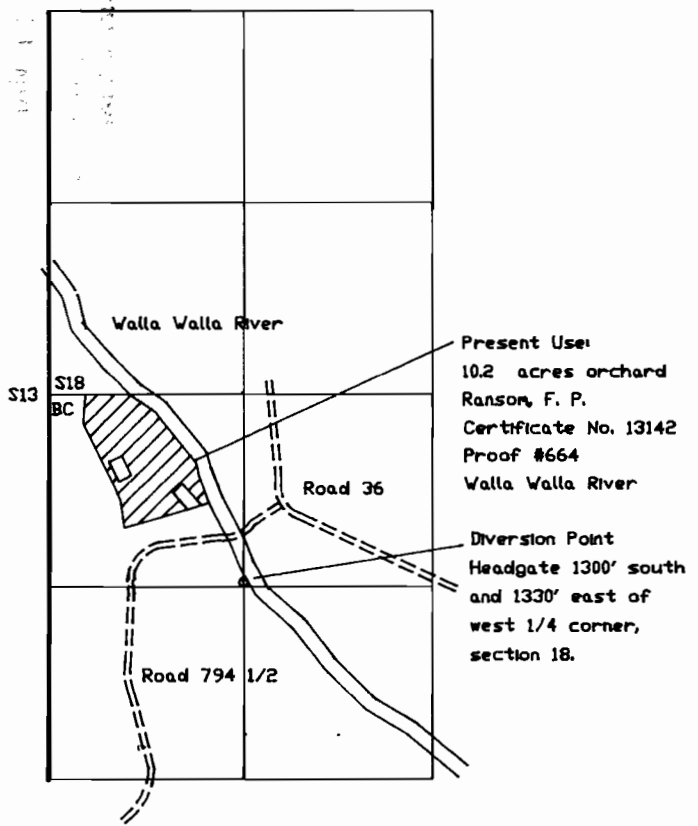

OWNER:
City of Milton Freewater
City Hall
722 South Main
Milton-Freewater, OR 97862
(503) 938-3149
541

Survey By:
CVRE 300
(renews 6-30-99)
David Haddock
P. O. Box 1574
Pendleton, OR 97801
(541)276-2174
March, 1999

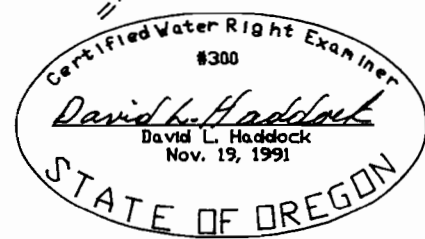

NOTE:
The information shown
on this map is solely
for Water Rights
purposes. The data
shown does not represent
ownership information.