


# T. 4N., R. 25E., W.M.

MORROW COUNTY

SCALE 1" = 1320'

COLUMBIA RIVER

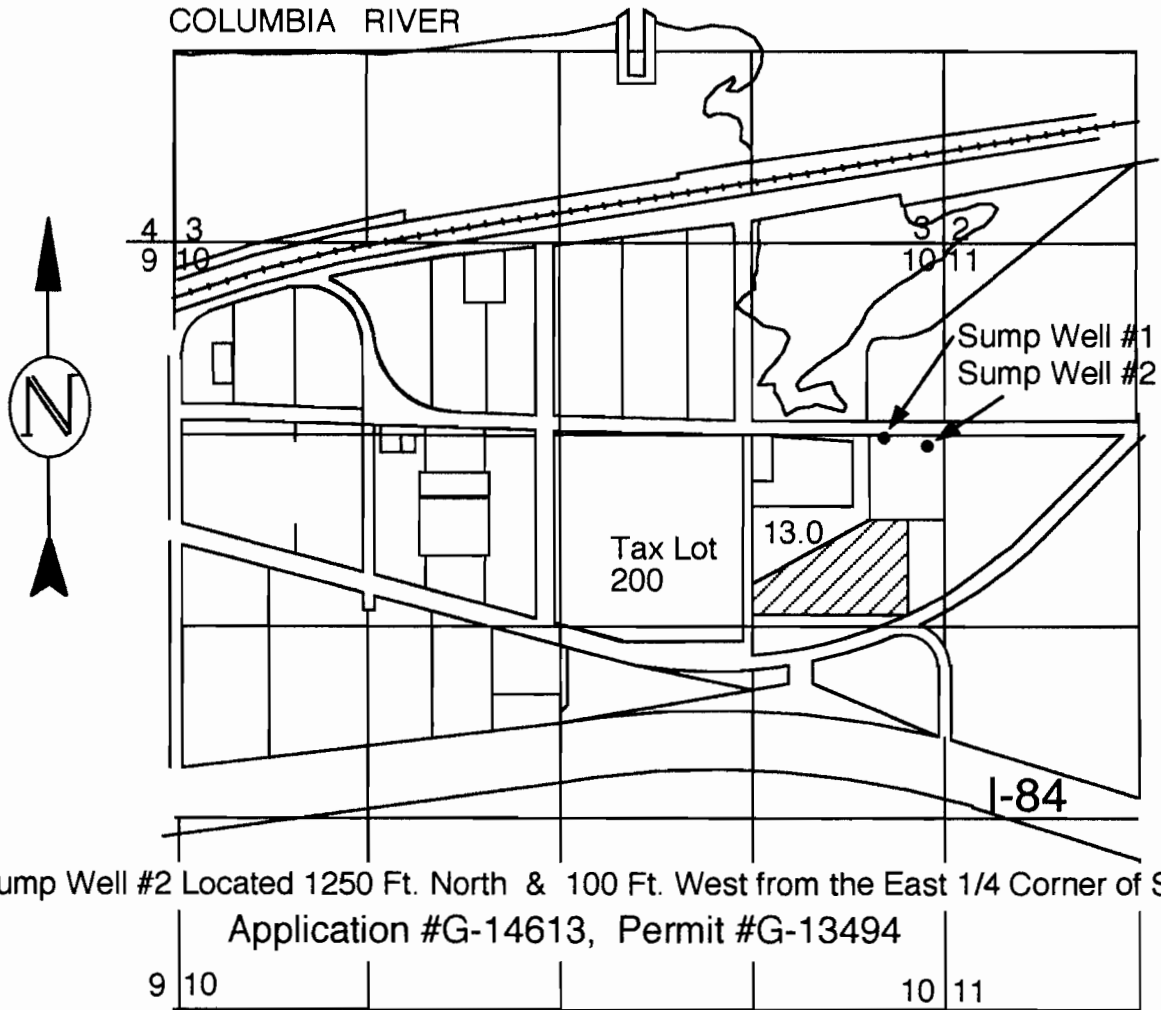

Sump Well #2 Located 1250 Ft. North & 100 Ft. West from the East 1/4 Corner of Section 10  
Application #G-14613, Permit #G-13494

 Water Use Found at This Location

WATER RIGHTS PROOF MAP  
IN NAME OF

*Port of Morrow &  
Joseph & Alice Tatone*

RECEIVED

SEP 30 2007

WATER RIGHTS DIVISION  



EXP. 12-31-02

THIS MAP IS FOR THE PURPOSE OF IDENTIFYING THE LOCATION OF WATER RIGHTS ONLY AND IS NOT INTENDED TO PROVIDE THE LEGAL DIMENSIONS OR LOCATIONS OF PROPERTY OWNERSHIP LINES.

ENGINEERING - LAND SURVEYING - WATER RIGHTS

**R. V. McKINNIS ENGINEERING**



79980 Prindle Loop Road  
Hermiston, Oregon 97838  
(541) -567-2017

