


1" = 400'

S.E. 1/4 SECTION 18

T. 3 S.

R. 4 E. W.M.

Application No. G-14483
Permit No.

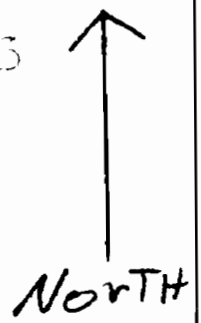

RECEIVED

JUN 25 1998

WATER RESOURCES DEPT.
SALEM, OREGON

1400

E 1/4 SECT →

1700 1491

1492

2200

1490

← 1/4 SECT →

S.W. 1/4 OF S.E. 1/4
Section 18
Township 3.S.
Range 4.E.

1/4 SECT

1/4 SECT

361' West
232' North
OF THE
S.E. Corner.

Well



Water to be used
in immediate area
of well for
washing + dust control

1480

2100

2101

2000

2001

1900

1901

1800

-361-

Section 18
Section 19