

PA 29417

Application No. G14639
Permit No. G13517

RECEIVED

NOV - 6 1997


WATER RESOURCES DEPT.
SALEM, OREGON

RECEIVED

NOV 20 1997

WATER RESOURCES DEPT.
SALEM, OREGON

T.2N.R.15E.W.M.

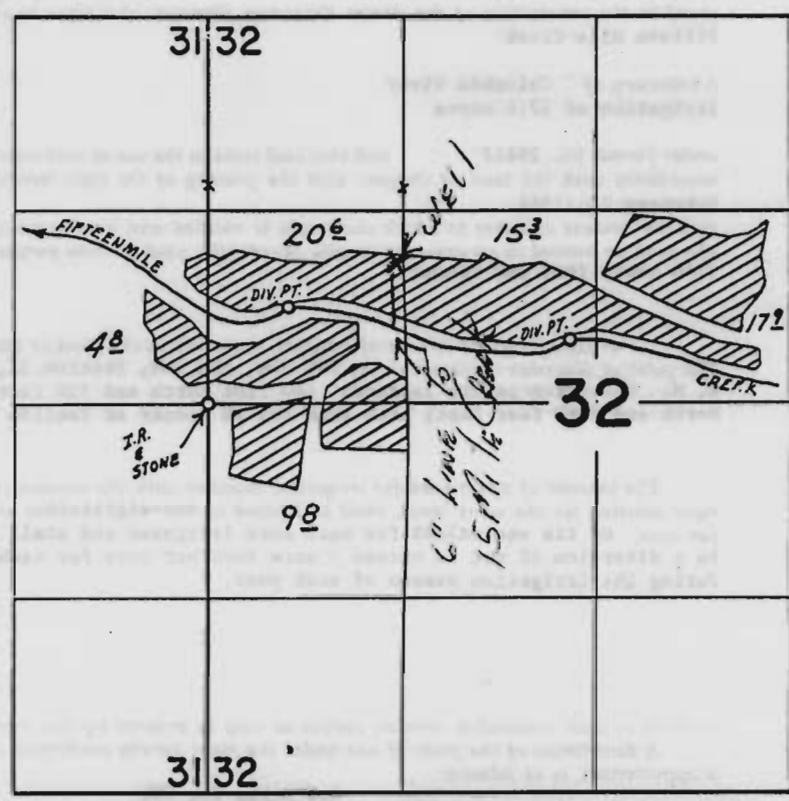

DIV. PTS. LOC.: 660' N. & 550' E.; 430' N. & 2460' E.; BOTH FROM
W 1/4 COR. SEC. 32

Well 1086 N & 1156 E

FINAL PROOF SURVEY
UNDER

Application No. 39580..... Permit No. 29417.....
IN NAME OF

ROBERT OLSON

Surveyed OCT. 29, 1970, by L.E. GOULD.....