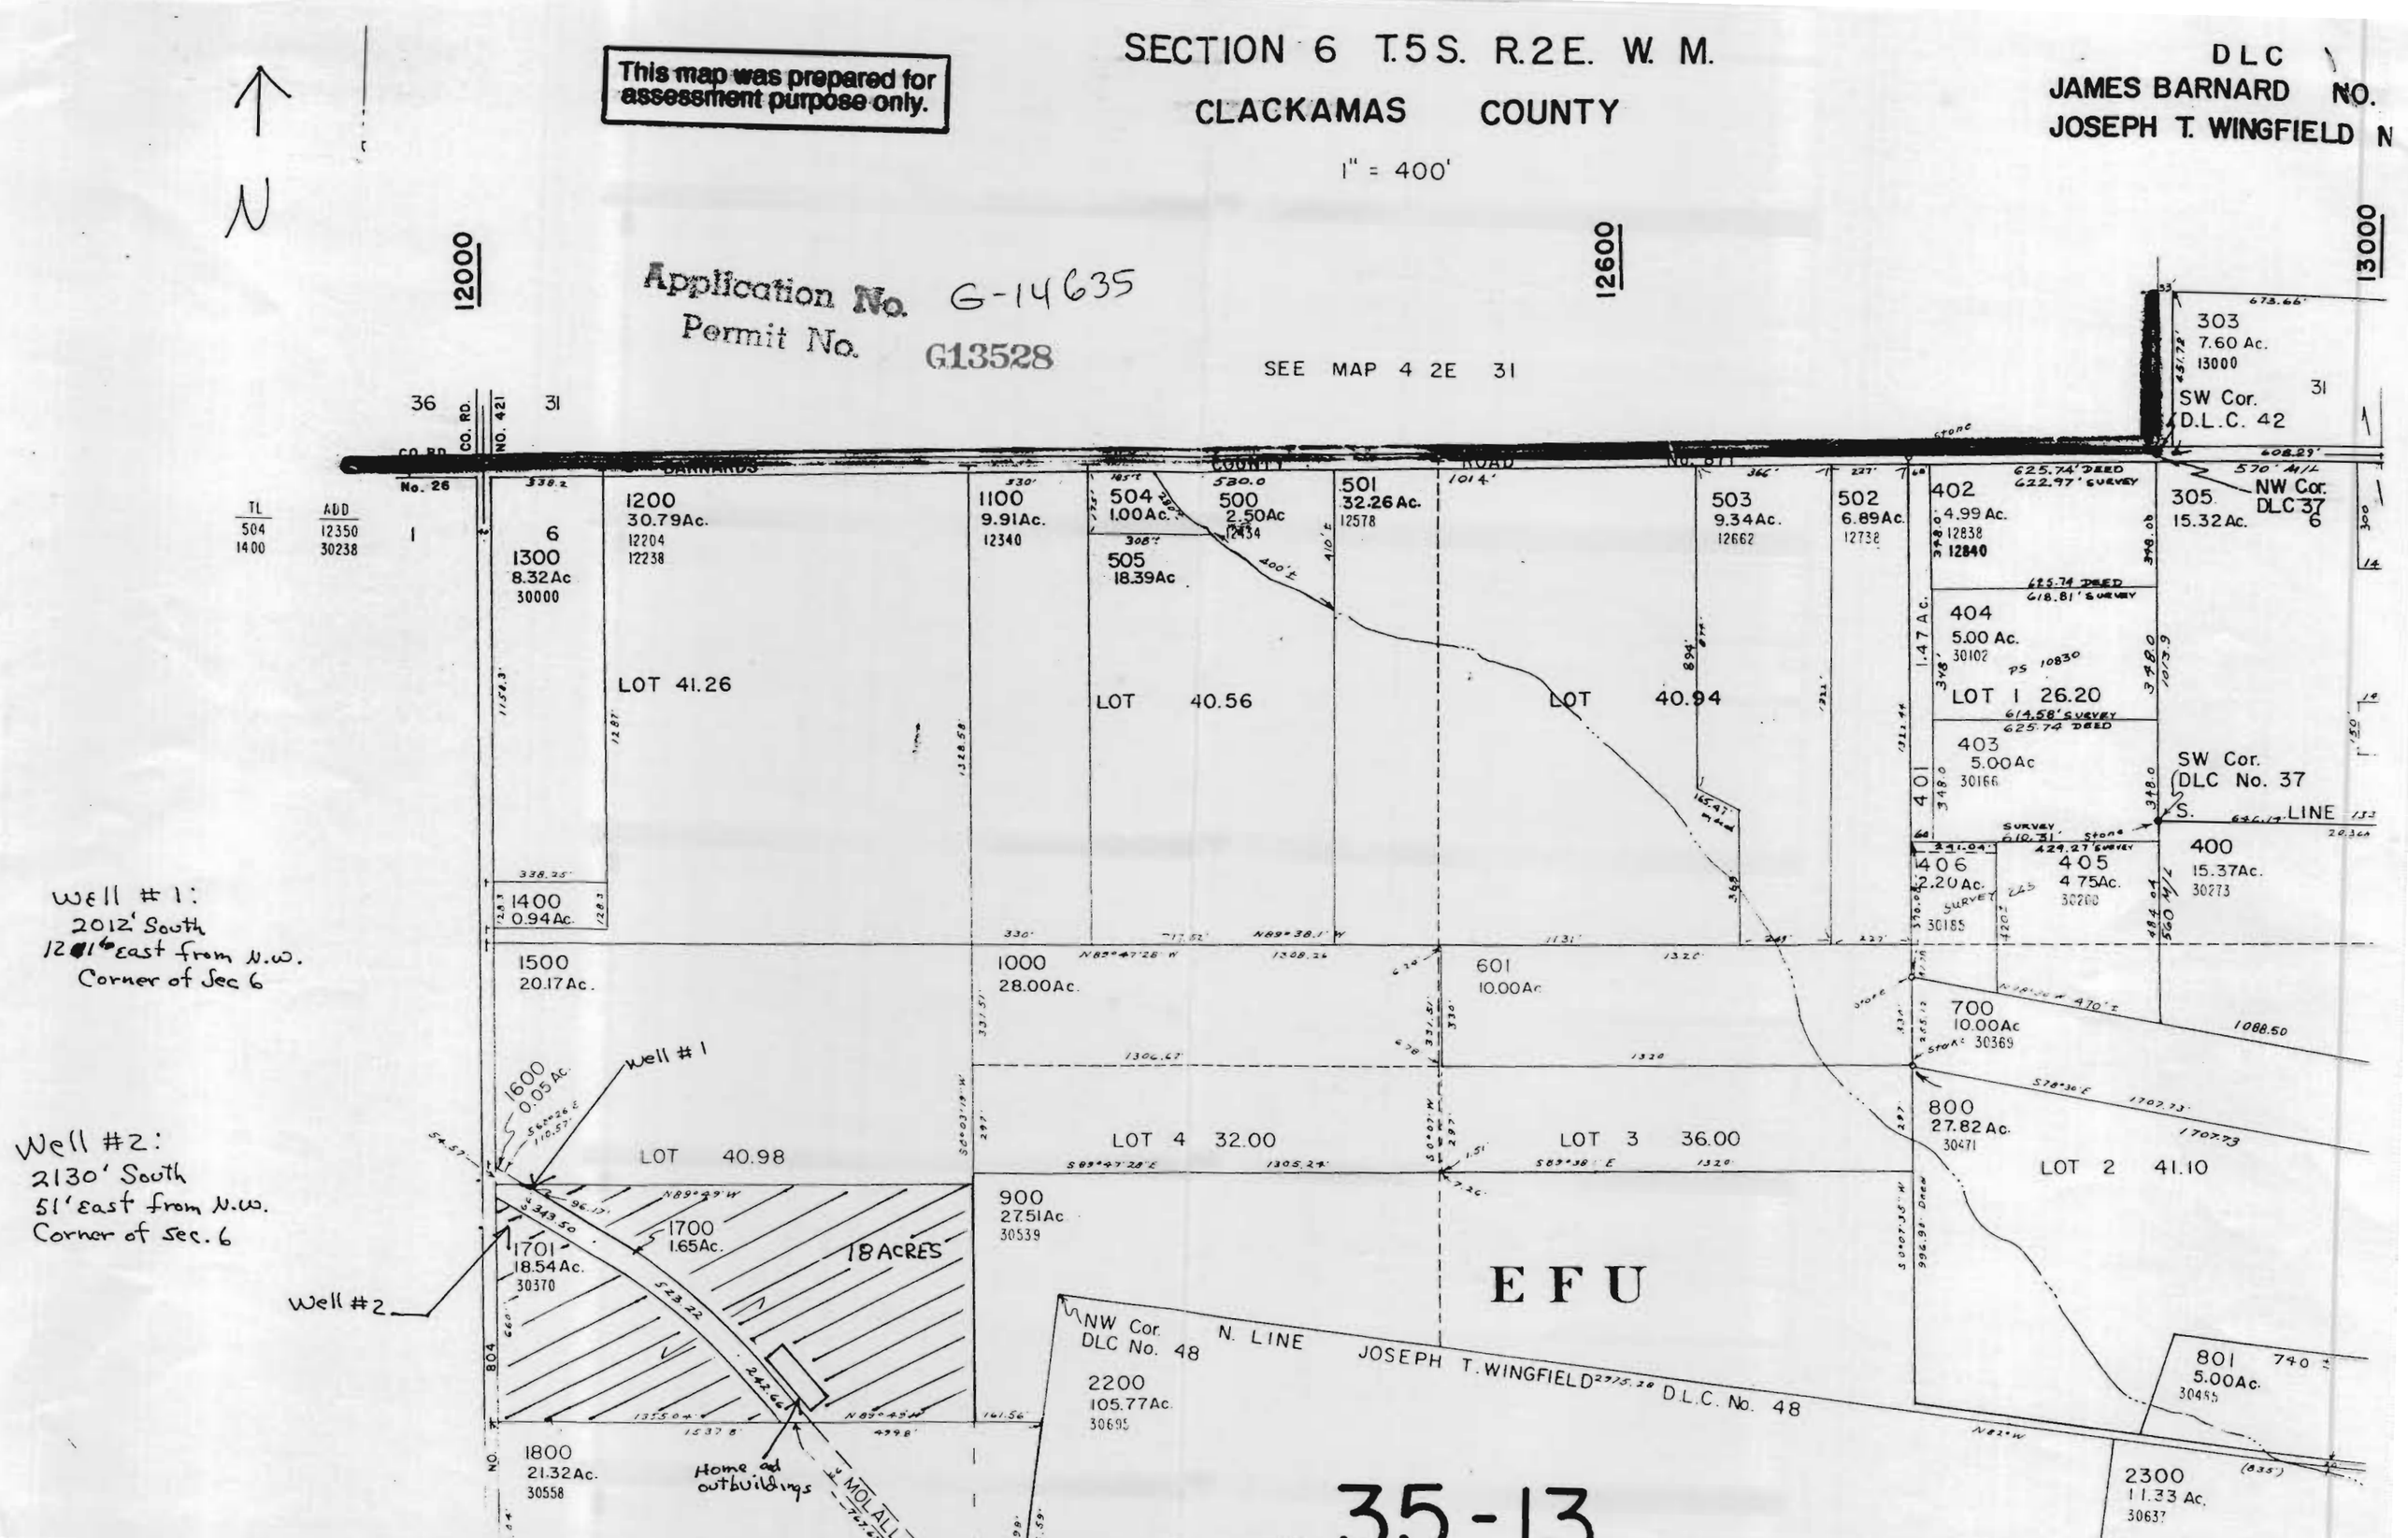

This map was prepared for assessment purpose only.
SECTION 6 T.5S. R.2E. W. M.
CLACKAMAS COUNTY
1" = 400'
DLC
JAMES BARNARD NO.
JOSEPH T. WINGFIELD N
N
Application No. G-14635
Permit No. G13528
SEE MAP 4 2E 31
12000
12600
13000
36
31
CO. RD.
NO. 421
No. 26
TL
504
1400
ADD
12350
30238
1
6
1300
8.32Ac
30000
1200
30.79Ac.
12204
12238
LOT 41.26
1100
9.91Ac.
12340
504
1.00Ac.
505
18.39Ac
500
2.50Ac
12434
LOT 40.56
501
32.26Ac.
12578
LOT 40.94
503
9.34Ac.
12662
502
6.89Ac.
12738
402
4.99 Ac.
12838
12840
404
5.00 Ac.
30102
LOT 1 26.20
403
5.00Ac
30166
401
1.47 Ac.
405
4.75Ac.
30200
406
2.20Ac.
30185
400
15.37Ac.
30273
303
7.60 Ac.
13000
SW Cor.
D.L.C. 42
NW Cor.
DLC 37
305
15.32Ac.
SW Cor.
DLC No. 37
S. LINE
1400
0.94Ac.
1500
20.17Ac.
1000
28.00Ac.
601
10.00Ac
700
10.00Ac
30369
800
27.82Ac.
30471
LOT 2 41.10
LOT 3 36.00
LOT 4 32.00
LOT 40.98
1600
0.05Ac.
Well #1
Well #2
1700
1.65Ac.
1701
18.54Ac.
30370
18 ACRES
900
27.51Ac
30539
EFU
NW Cor.
DLC No. 48
N. LINE
JOSEPH T. WINGFIELD
D.L.C. No. 48
2200
105.77Ac.
30695
801
5.00Ac.
30485
2300
11.33 Ac.
30637
1800
21.32Ac.
30558
Home and outbuildings
MOLALLA
Well #1:
2012' South
12[illegible]1' east from N.W.
Corner of Sec 6
Well #2:
2130' South
51' east from N.W.
Corner of Sec. 6
35-13