


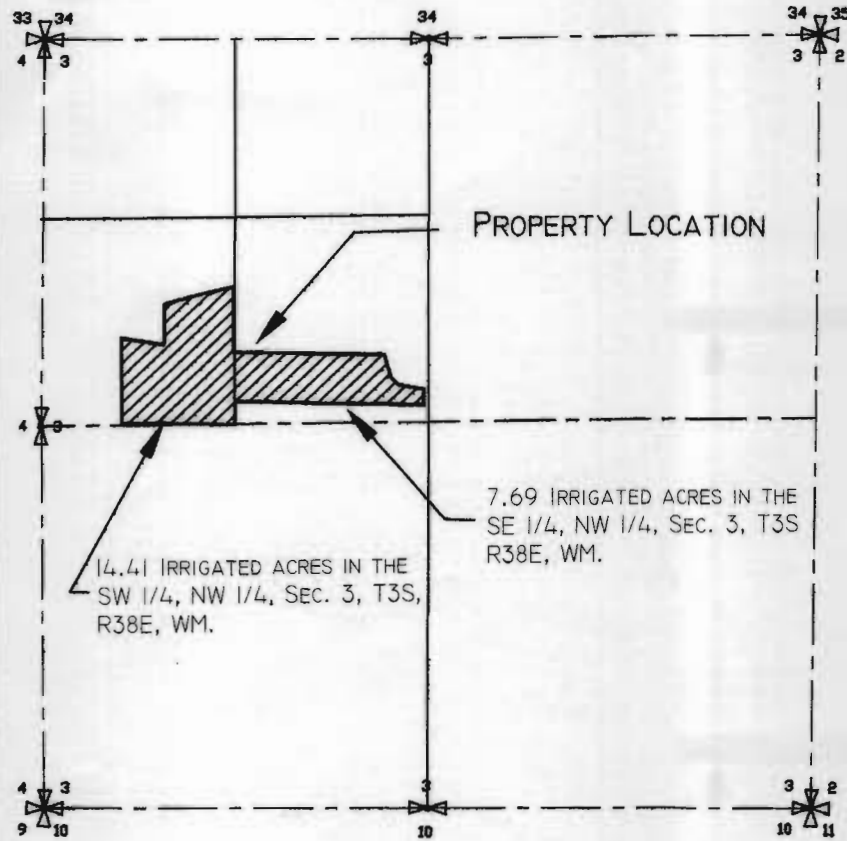

TOWNSHIP 3 SOUTH, RANGE 38 EAST SECTION 4

VICINITY MAP

SCALE 1" = 1320'

NARRATIVE


THIS REFERENCE WAS MADE AT THE REQUEST OF KEVIN HAMPTON FOR THE PURPOSE OF ESTABLISHING WATER USE FOR THE PROPERTY SHOWN.



LOCATED IN THE NW 1/4, OF THE SW 1/4 OF SECTION 3
TOWNSHIP 3 SOUTH RANGE 38 EAST IN THE WILLAMETTE
MERIDIAN IN UNION COUNTY, OREGON.

FINAL PROOF MAP

APPLICATION #G14618
PERMIT #G13547

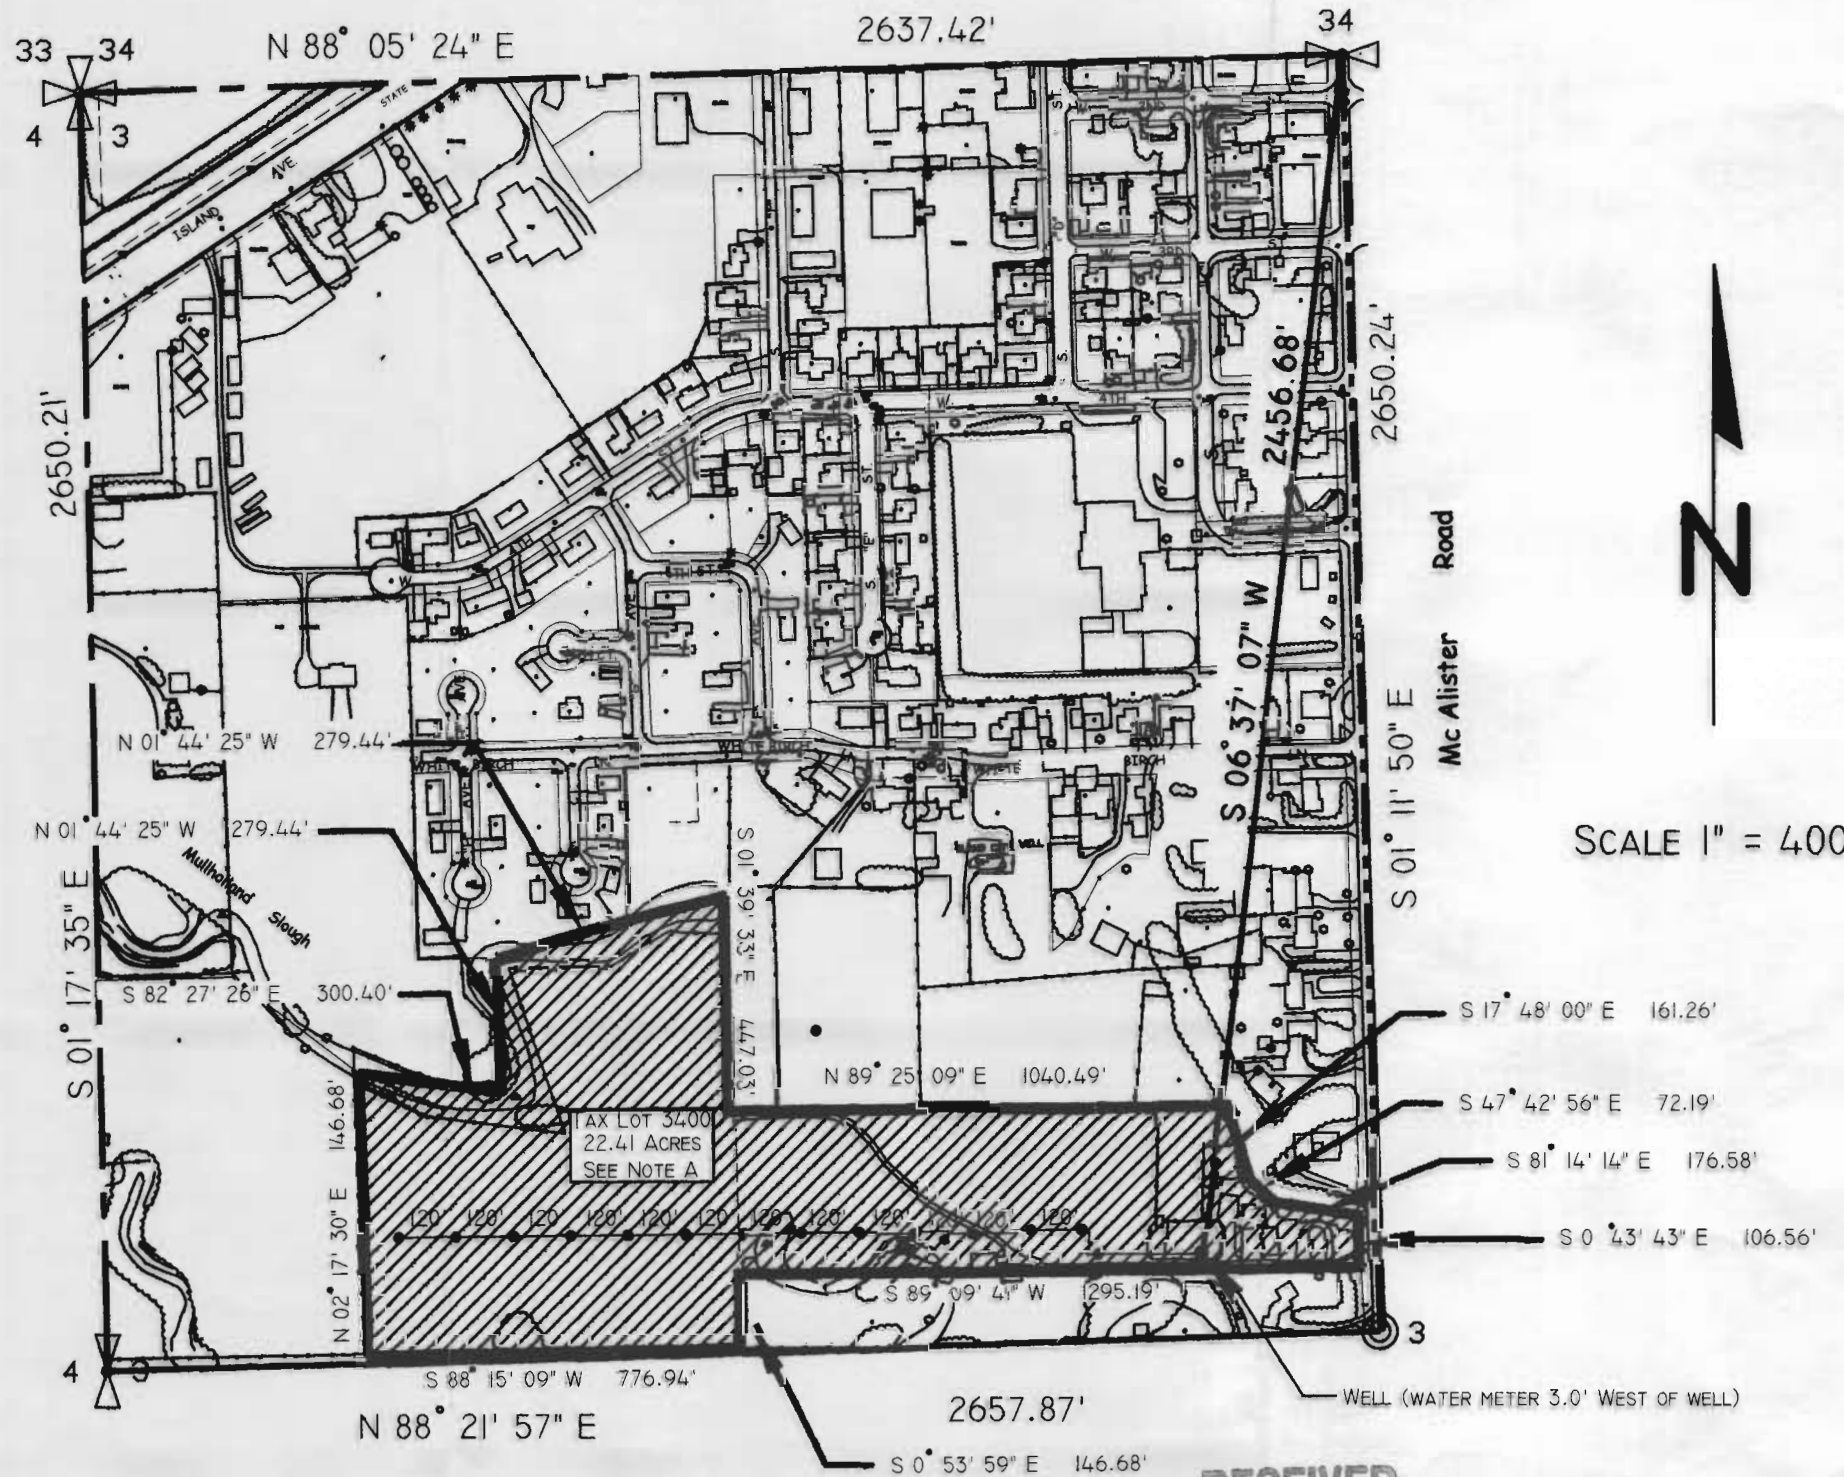

COBU MAP # 0275

NOTE: THIS MAP WAS PREPARED FOR THE PURPOSE OF IDENTIFYING THE LOCATION OF A WATER RIGHT ONLY AND IS NOT INTENDED TO PROVIDE LEGAL DIMENSIONS OR LOCATIONS OF PROPERTY OWNERSHIP LINES.

NOTE A: 22.41 TOTAL ACRES
0.31 IMPROVED ACRES
22.10 IRRIGATED ACRES

RECEIVED

JUL 18 2007

WATER RESOURCES DEPT
SALEM, OREGON

NORM PAULLUS & ASSOC.

DATE: 5 / 20 / 06

SCALE 1" = 400'

SHEET: 1 OF 1