



T 22 S, R 31 E, WM

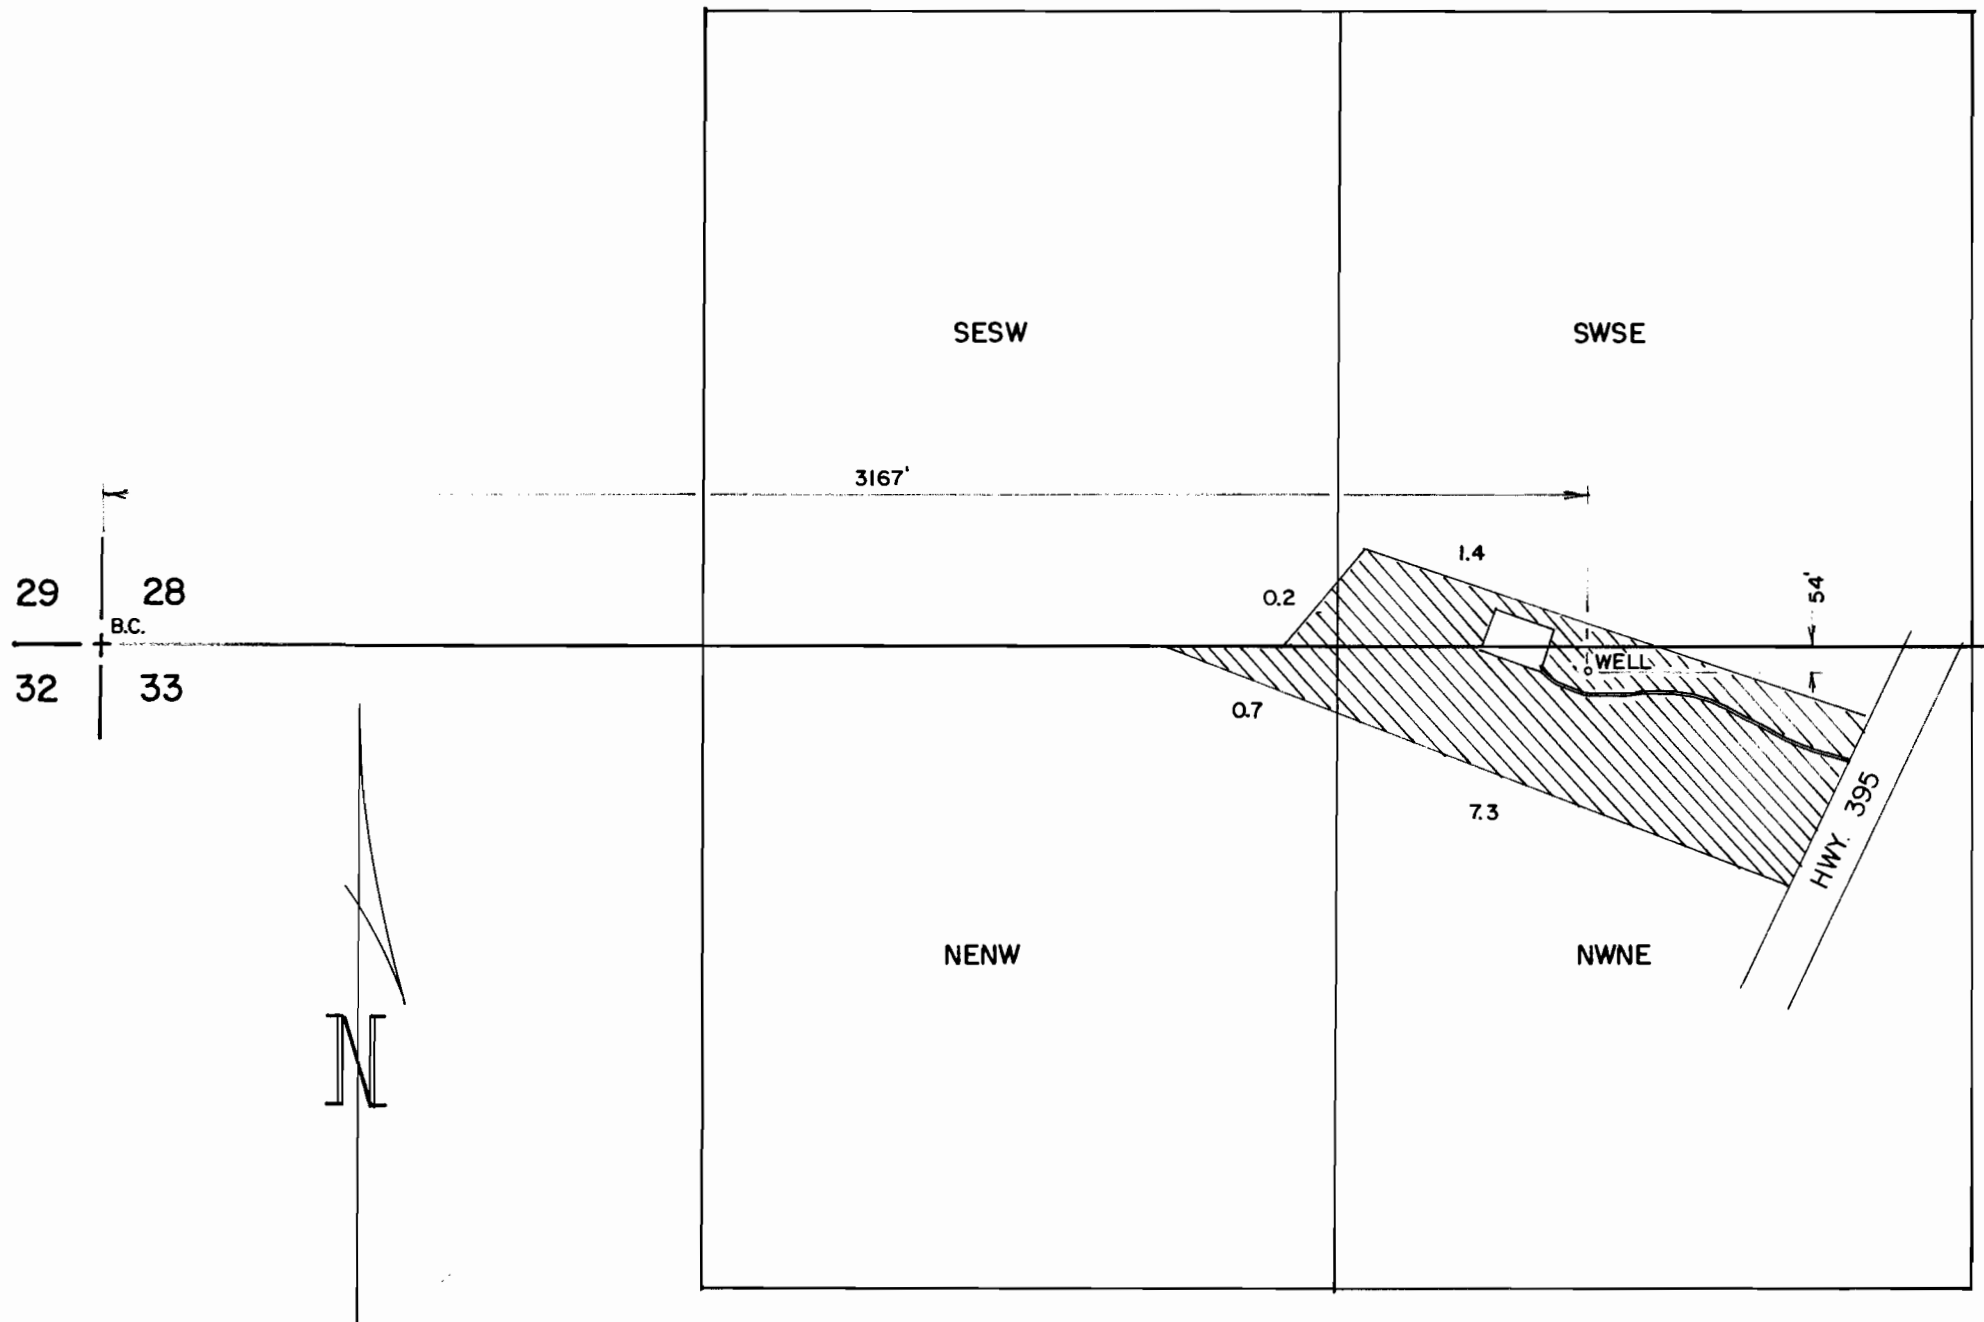

NOTE

IRRIGATED AREA IS WITHIN TAX LOT 100 MAP 22S, 31E, 28.



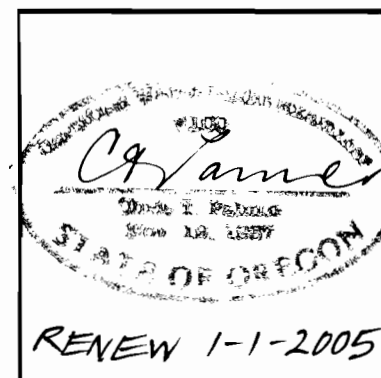

UNDER
APPLICATION G-14079
PERMIT G-13566

FINAL PROOF SURVEY

IN THE NAME OF
PHILIP H. TURRELL

Scale: 1" = 400'

Date: JULY 2004

Job: 1575-04

Dsn:

Drm: CHRIS

Ckd:



ENGINEERING & SURVEYING
711 Ponderosa Village • Box 61
Burns, Oregon 97720

Sht. No.

of 1