


SEE MAP 06 2W 09

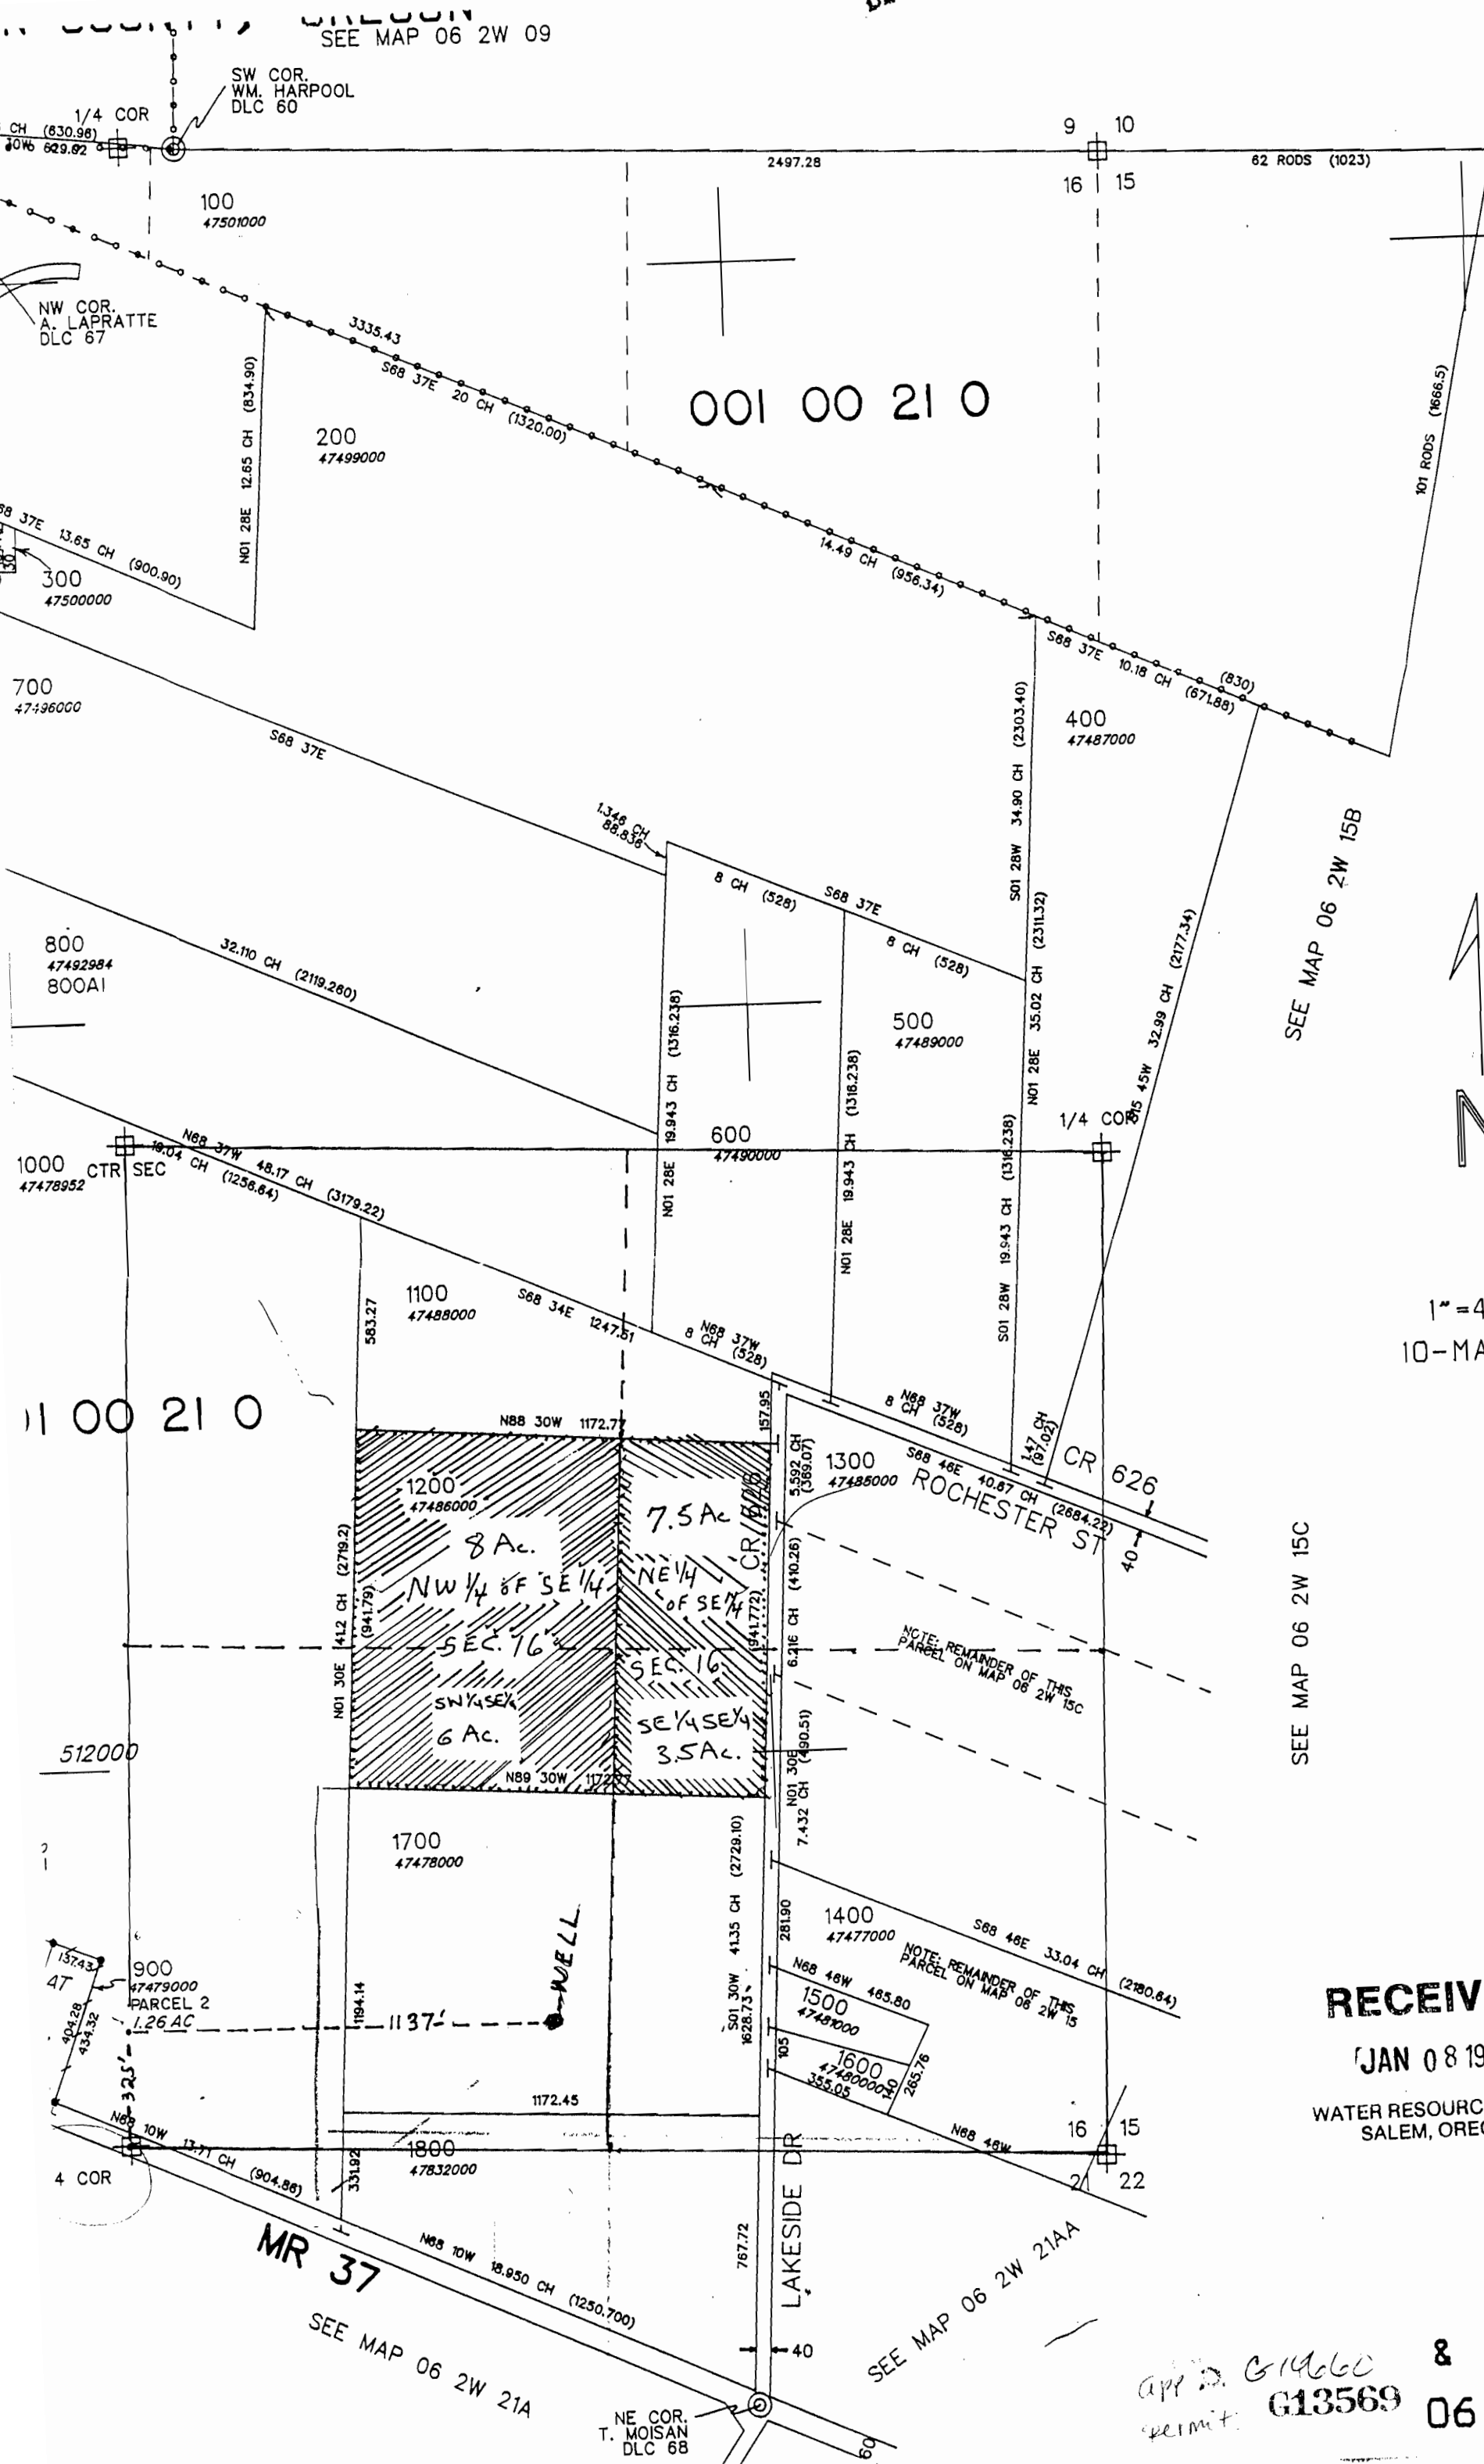

1"=400'
10-MAR-92

SEE MAP 06 2W 15C

RECEIVED

JAN 08 1998

WATER RESOURCES DEPT.
SALEM, OREGON

MR 37

SEE MAP 06 2W 21A

SEE MAP 06 2W 21AA

APP'D. G1466C
G13569
permit

& INDEX
06 2W 16