

WATER RIGHT MAP

RECEIVED


LANDSCAPE PLANT DEVELOPMENT CENTER  
c/o J. FRANK SCHMIDT

MAR 14 1938

WATER RIGHTS DIVISION  
SALIDA, OREGON

9500 S.E. 327TH  
BORING, OR 97009


TOWNSHIP 4 SOUTH,  
RANGE 1 WEST, W.M.  
SECTION 8

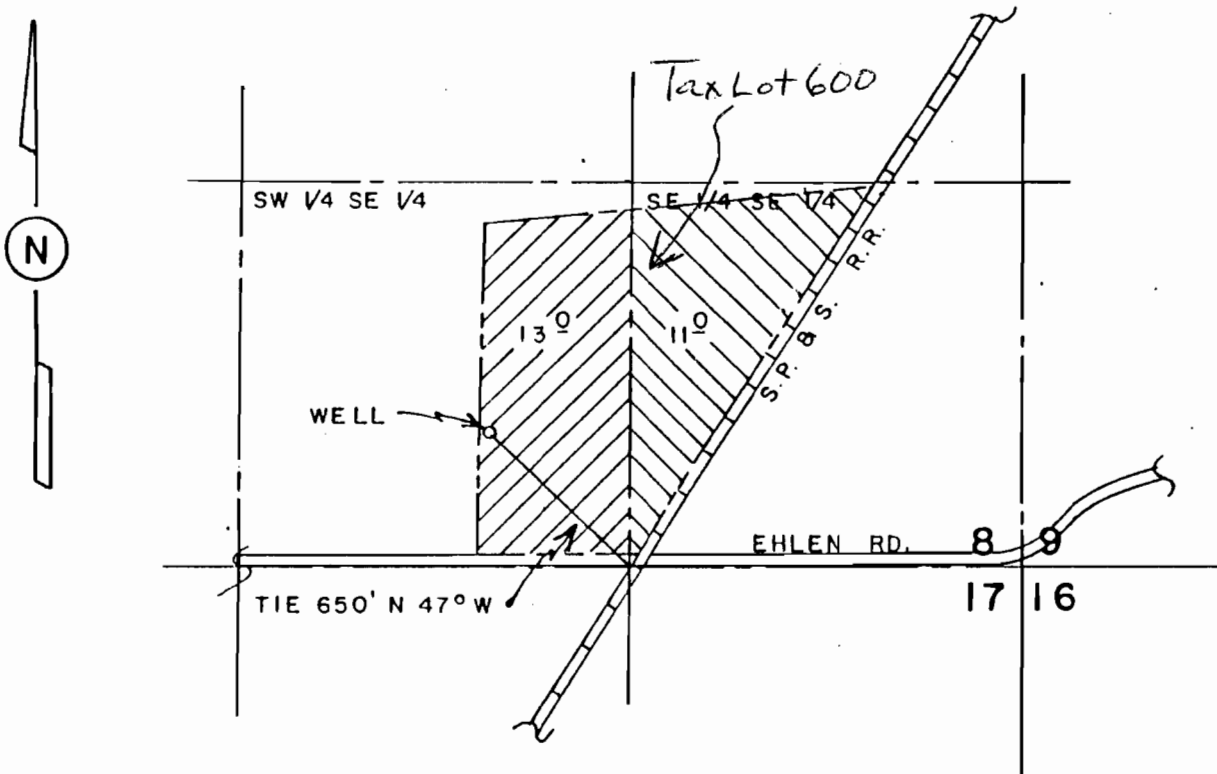


PREPARED BY P.G.E.

SCALE: 1" = 660 FT.

DFN-2 DD-45

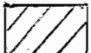 IRRIGATION, SW 1/4 SE 1/4

6-14710

 IRRIGATION, SE 1/4 SE 1/4

613574