


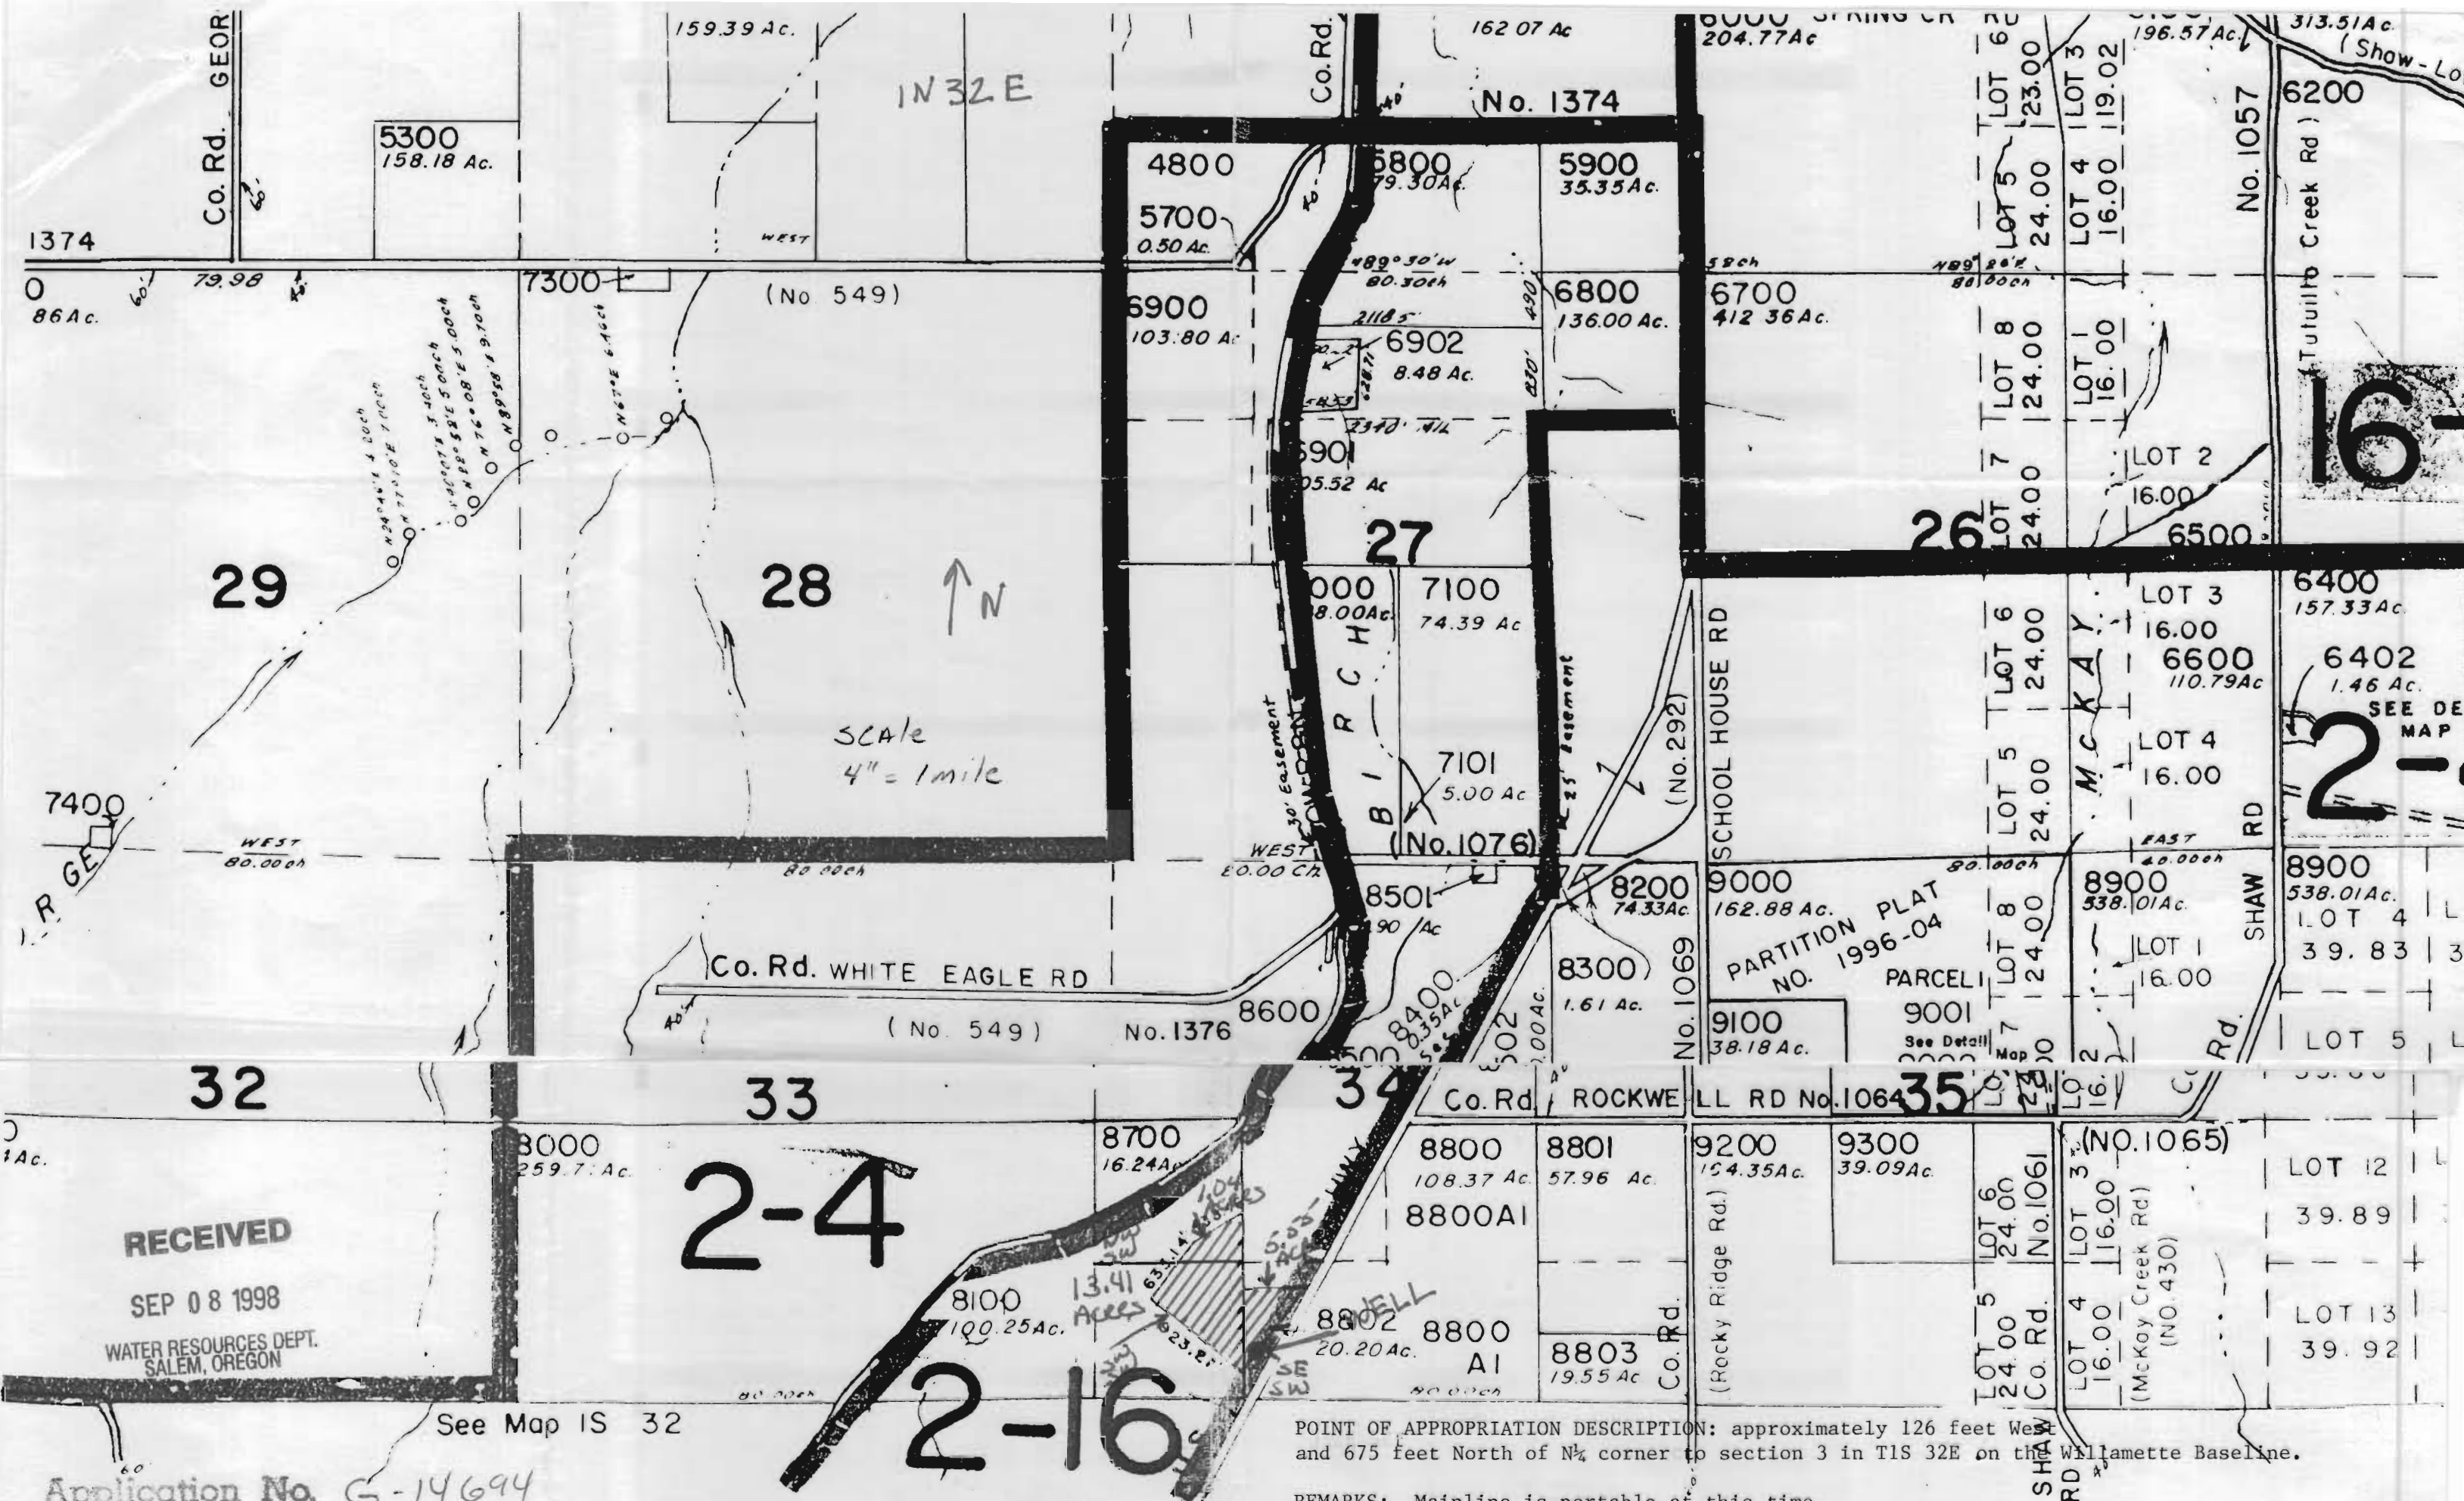

Application No. G-14694
Permit No. G13588