


FINAL PROOF SURVEY MAP IN THE NAME OF JOHN MEYER

APPLICATION G-14766

PERMIT G-13589

SECTION 12, TOWNSHIP 29 SOUTH, RANGE 15 WEST, W.M.

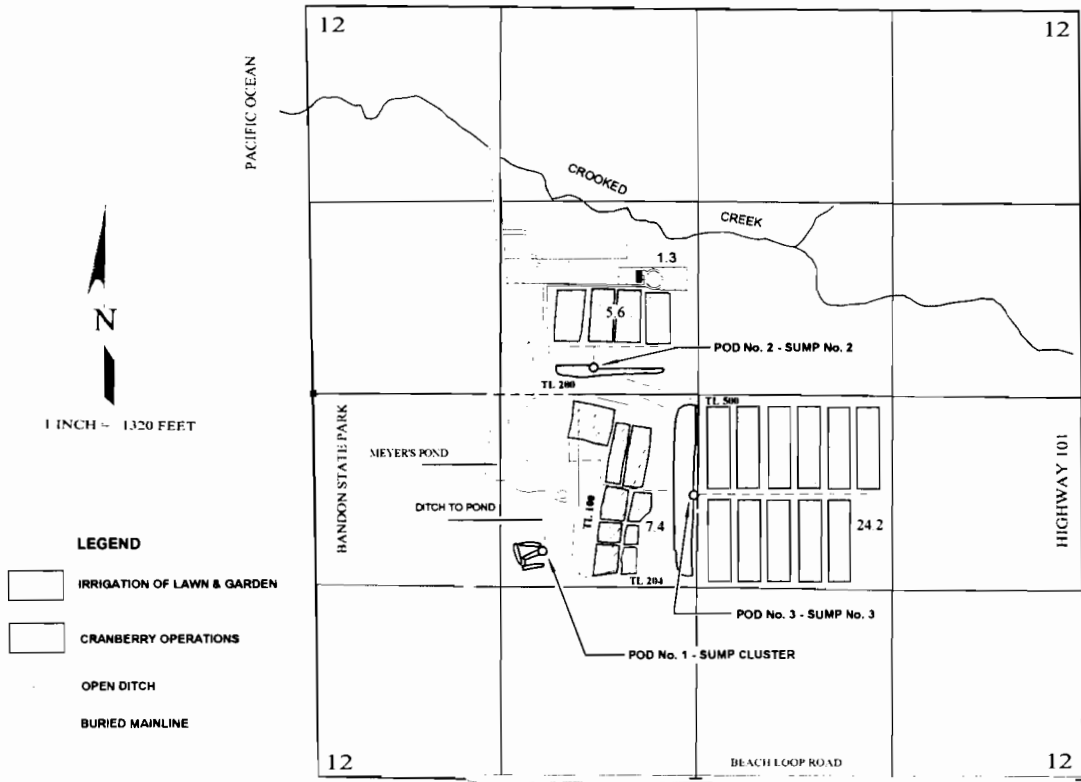

THE POINTS OF DIVERSION ARE LOCATED AS FOLLOWS:

POD No. 1: 1090 FEET SOUTH AND 1575 FEET EAST, WITHIN THE NE $\frac{1}{4}$ SW $\frac{1}{4}$;

POD No. 2: 180 FEET NORTH AND 1930 FEET EAST, WITHIN THE SE $\frac{1}{4}$ NW $\frac{1}{4}$; AND


POD No. 3: 705 FEET SOUTH AND 2600 FEET EAST, WITHIN THE NE $\frac{1}{4}$ SW $\frac{1}{4}$;

ALL FROM THE WEST QUARTER CORNER OF SECTION 12 AND WITHIN SECTION 12,
TOWNSHIP 29 SOUTH, RANGE 15 WEST, W.M.; COOS COUNTY.

RECEIVED

SEP 9 2004

W. J. SALEM OFFICIAL

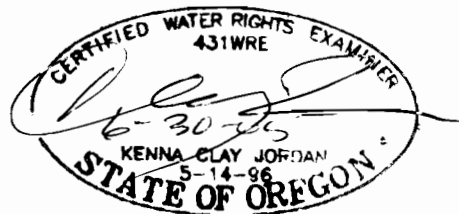

THE PURPOSE OF THIS MAP IS TO IDENTIFY THE LOCATION OF THE WATER RIGHT.
IT IS NOT INTENDED TO PROVIDE INFORMATION RELATIVE TO THE LOCATION OF
PROPERTY OWNERSHIP BOUNDARY LINES.