
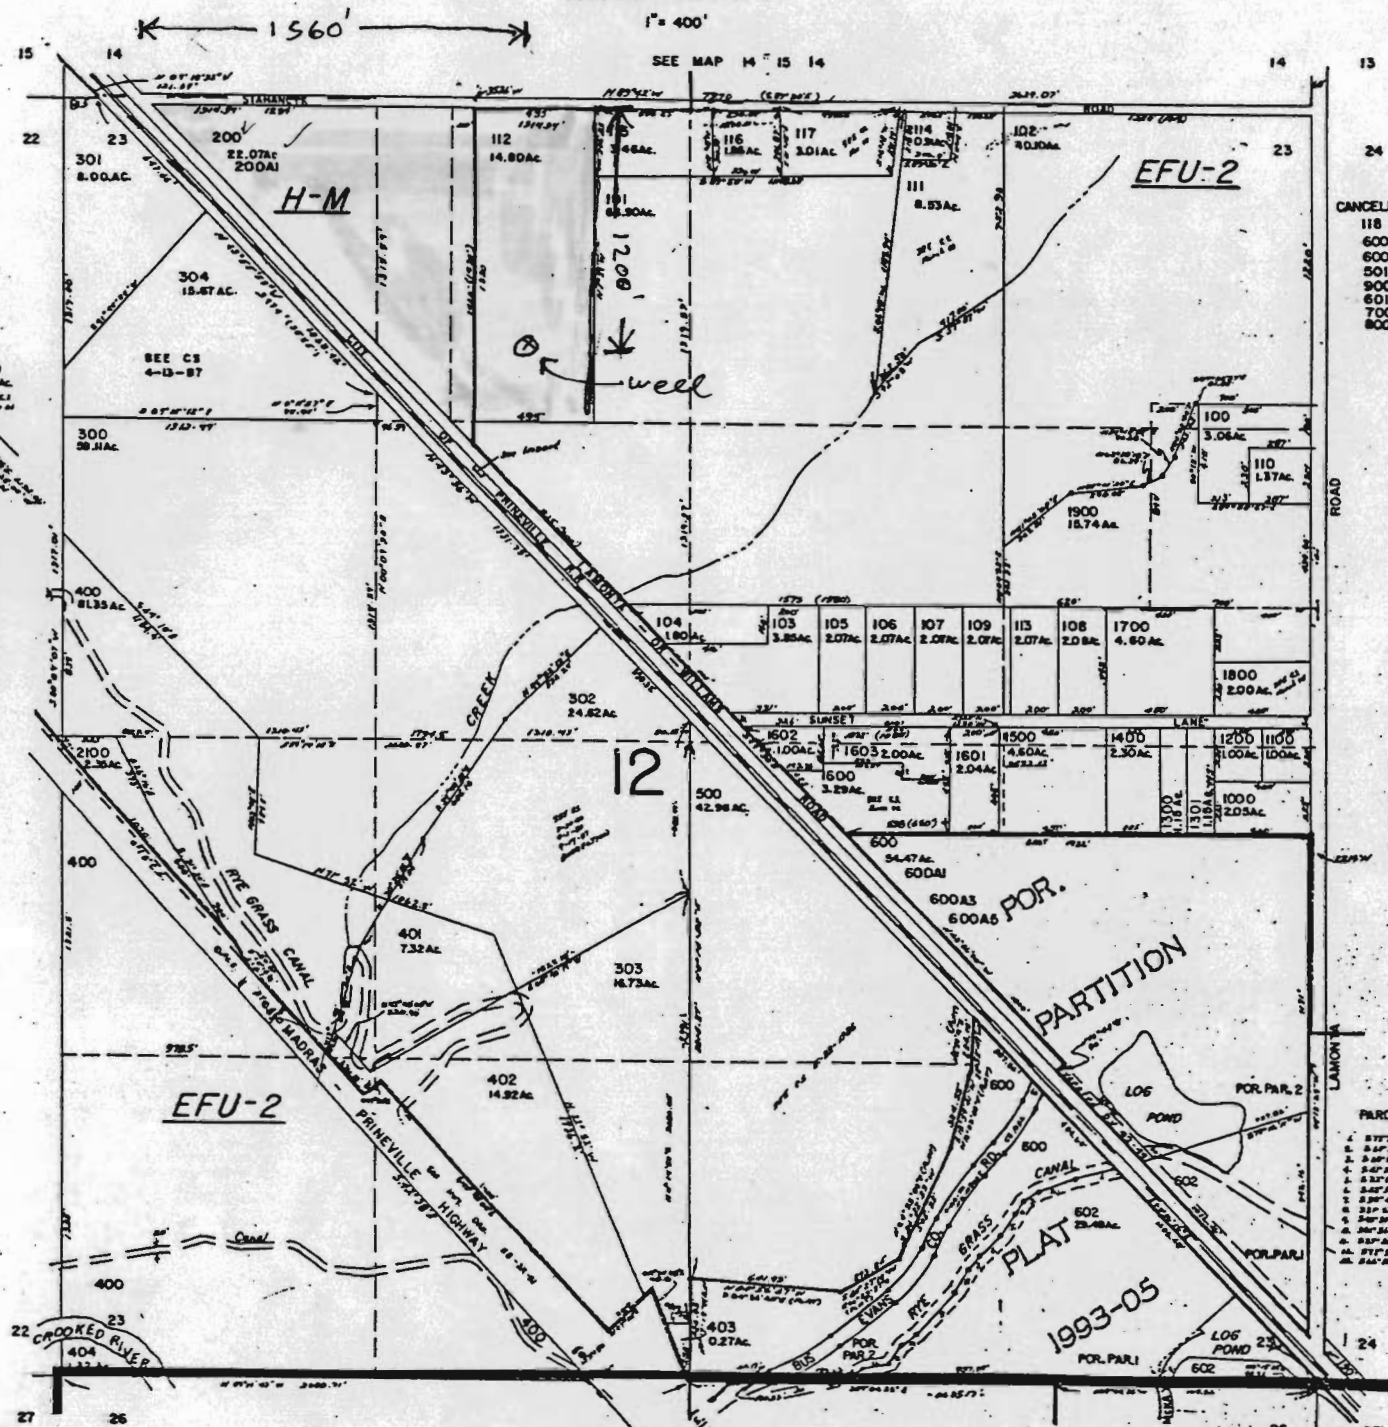


This map was prepared for assessment purpose only.

SECTION 23 T.14S R.15E W.M.
CROOK COUNTY

14 15 23

SCALE 1:9600

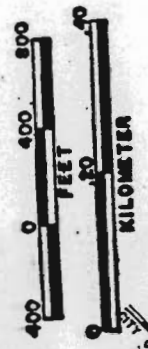

- CANCELLED NO'S
- 118
 - 600A4
 - 600A2
 - 501
 - 900
 - 601
 - 700
 - 800

WATER RESOURCES DEPT.
SALEM, OREGON

APR 16 1998

RECEIVED

Parcel No. 613590
614725

RECEIVED
JUL 15 1993
DEPT. OF REVENUE STATE OF OREGON
ASSESSMENT & APPRAISAL DIV.

PARCEL SIZE

1	1.00 AC
2	1.00 AC
