


T 2 S R 39 E

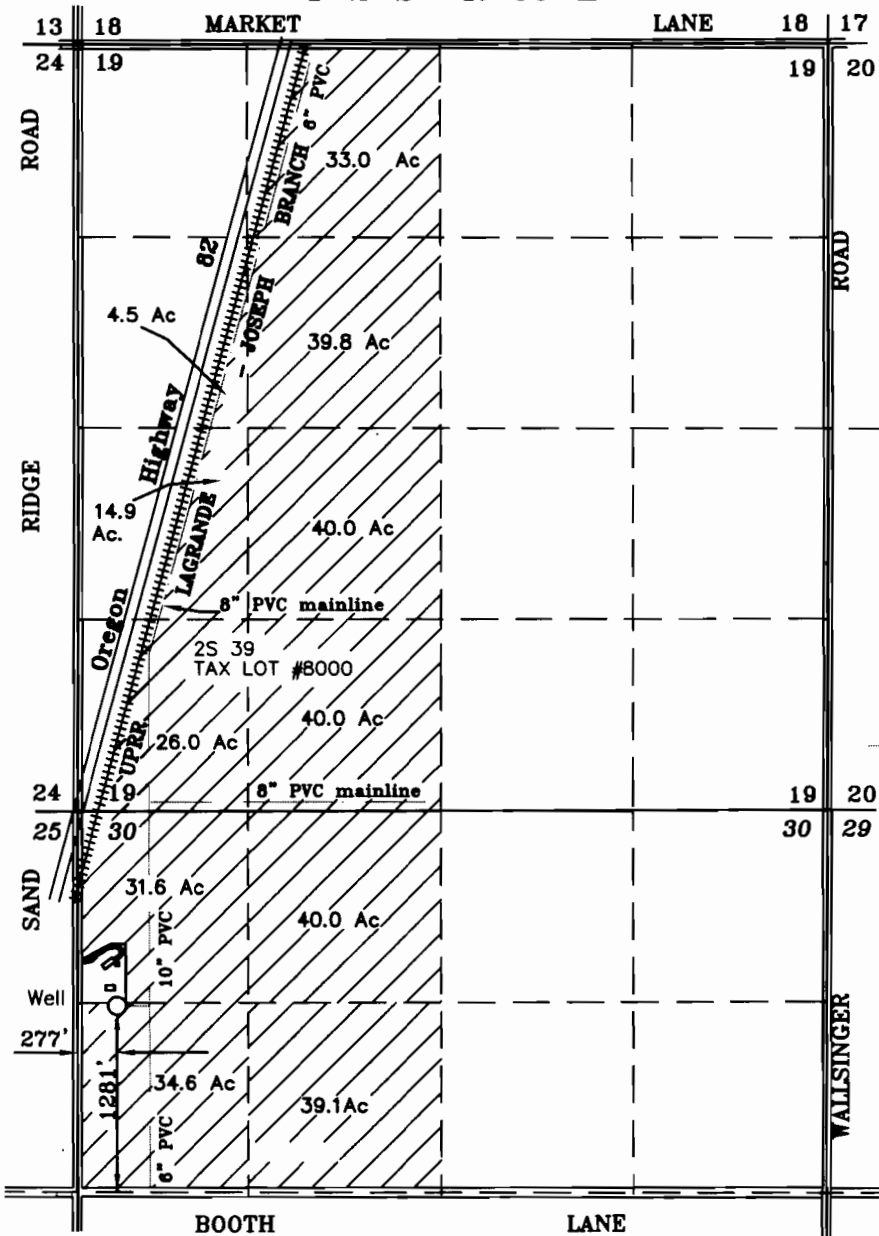

SCALE 1" = 1320'



Lands being irrigated from new well.

Mainline


**FINAL PROOF MAP**  
**FOR**  
**WATER RIGHTS**  
**FROM A NEW WELL**  
**FOR**  
**DONALD V. WRIGHT**  
**BY**

BAGETT - GRIFFITH & BLACKMAN  
 2006 ADAMS AVENUE  
 LAGRANDE, OREGON 97850

September 29, 2004

APPLICATION NO. : G - 14705

PERMIT NUMBER : G - 13593

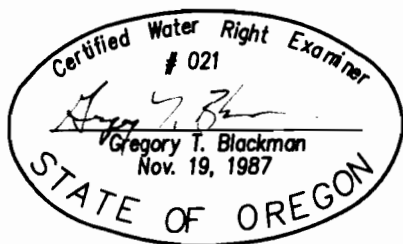

NOTE: The preparation of this map was for the purpose of identifying the location of the proposed water right and has no intent to provide dimensions or location of property ownership lines. Location information shown hereon was furnished by the applicant.