TOWNSHIP 15 SOUTH, RANGE 13 EAST, W. M.

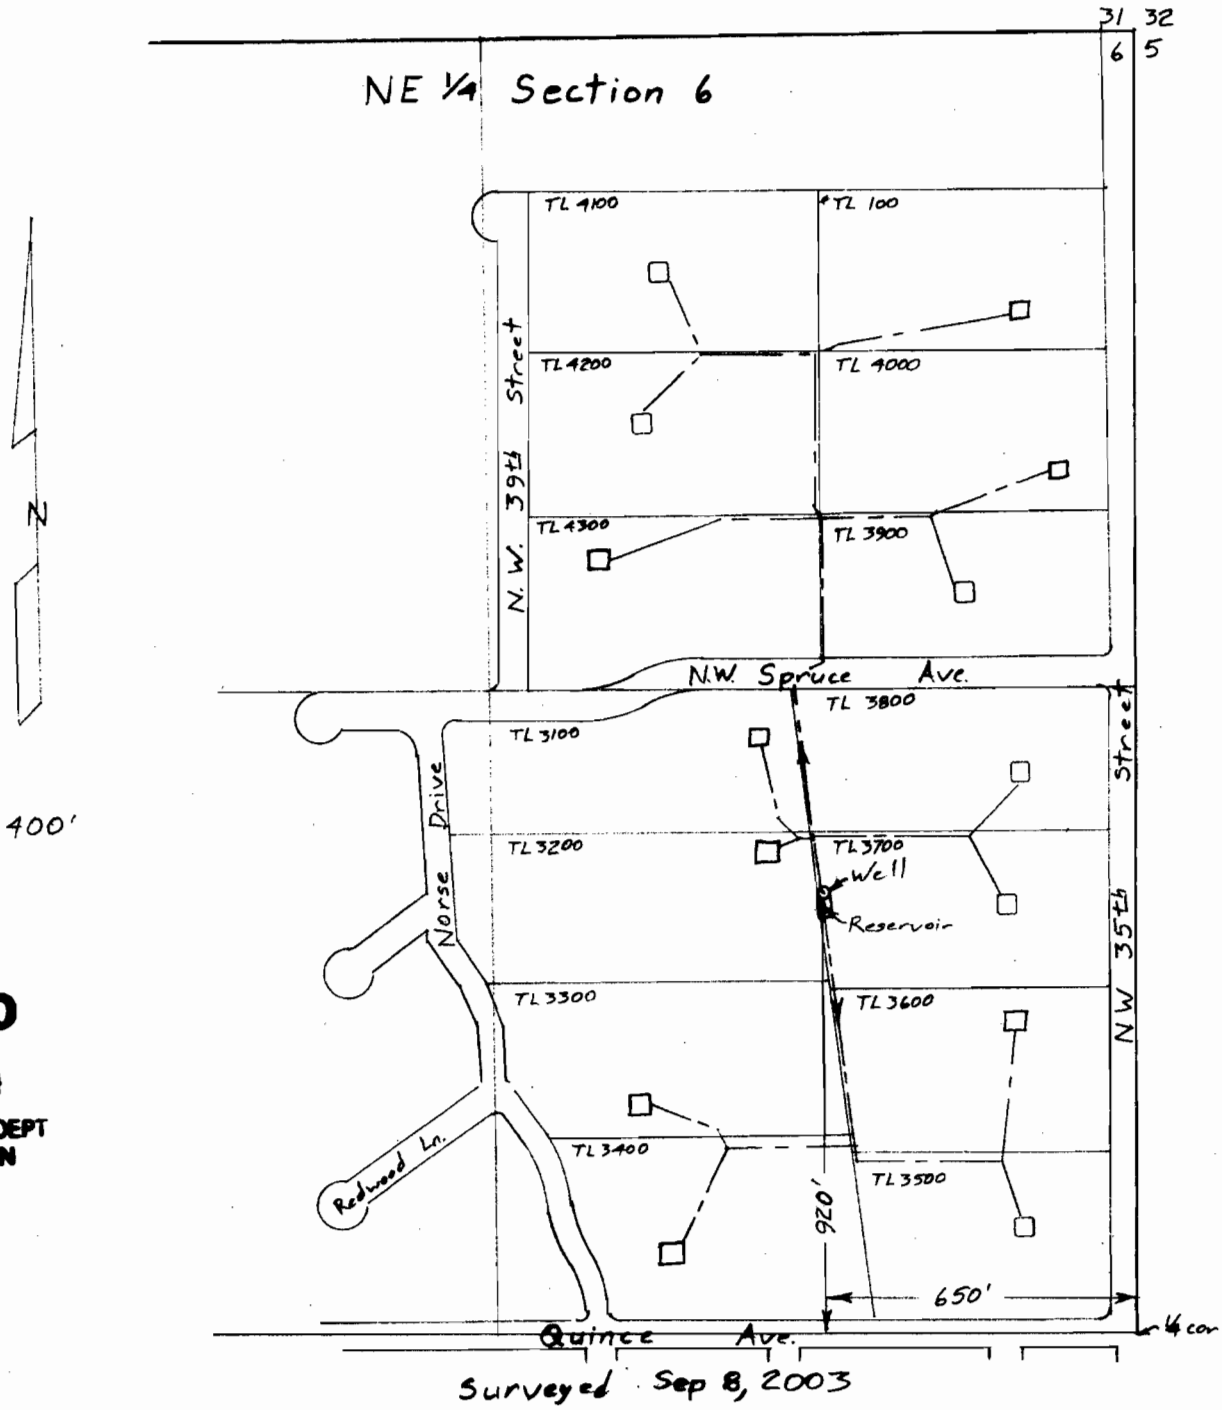

Surveyed Sep 8, 2003

RECEIVED
JUL 02 2004
WATER RESOURCES DEPT
SALEM, OREGON

Claim of Beneficial Use Map
for
HIDDEN VALLEY ESTATES #2

App G-14675
Per G-13603

Certified Water Right Examiner #1
Bruce A. Estes
Nov. 19, 1987
STATE OF OREGON
Renewal Dec 31, 2005

This map is for the purpose of locating a water right only and has no intent to provide legal dimensions or the location of property lines.

ESTES SURVEYS, LLC
6293 Sunnyview Rd. NE
Salem, OR 97305
(503) 585-7593
60382 Arnold Rd.
Bend, OR 97702
(503) 382-7391