


# T 5 S, R 2 W, WM

MARION COUNTY

*Bourgean*  
DLC No. 68

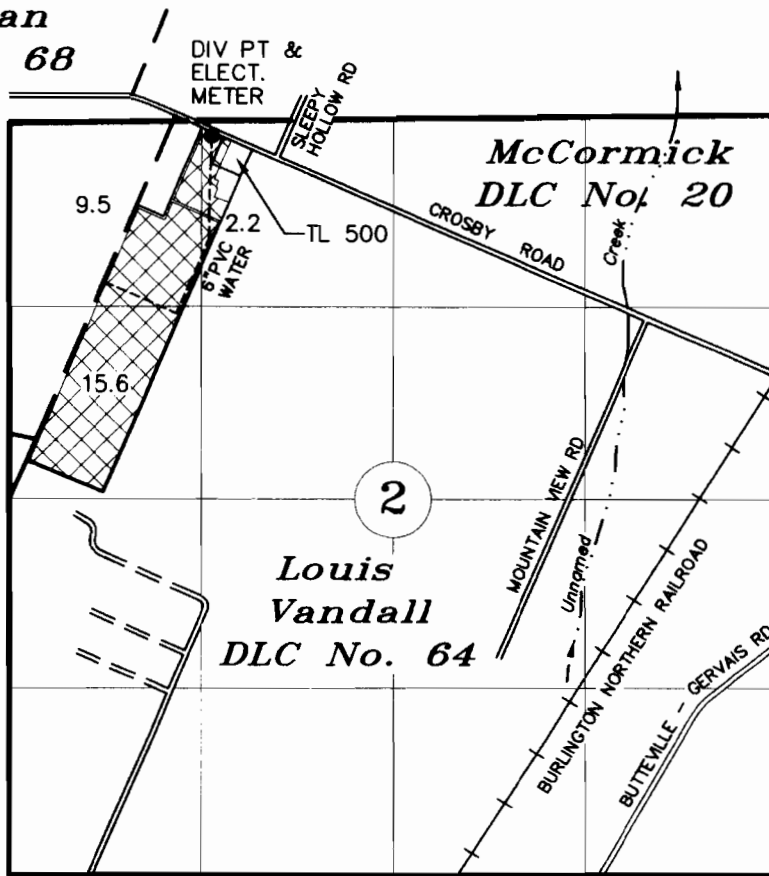

TAX LOT:  
5 2W 02 500  
5 2W 02 600



DIV. PT.: 149' S AND 246' E OF THE NW CORNER LOUIS VANDALL DLC No.64,

## FINAL PROOF SURVEY

UNDER

Application No. G-14805

Permit No. G-13622

**RECEIVED**

IN THE NAME OF

**KEVIN CROSBY**

JUNE 22, 2006

SCALE: 1" = 1320'



NOTE: This map is not intended to provide legal dimensions or locations of property ownership lines.

EXPIRES 12-31-07