


Twp 7 S., R.

Block
75

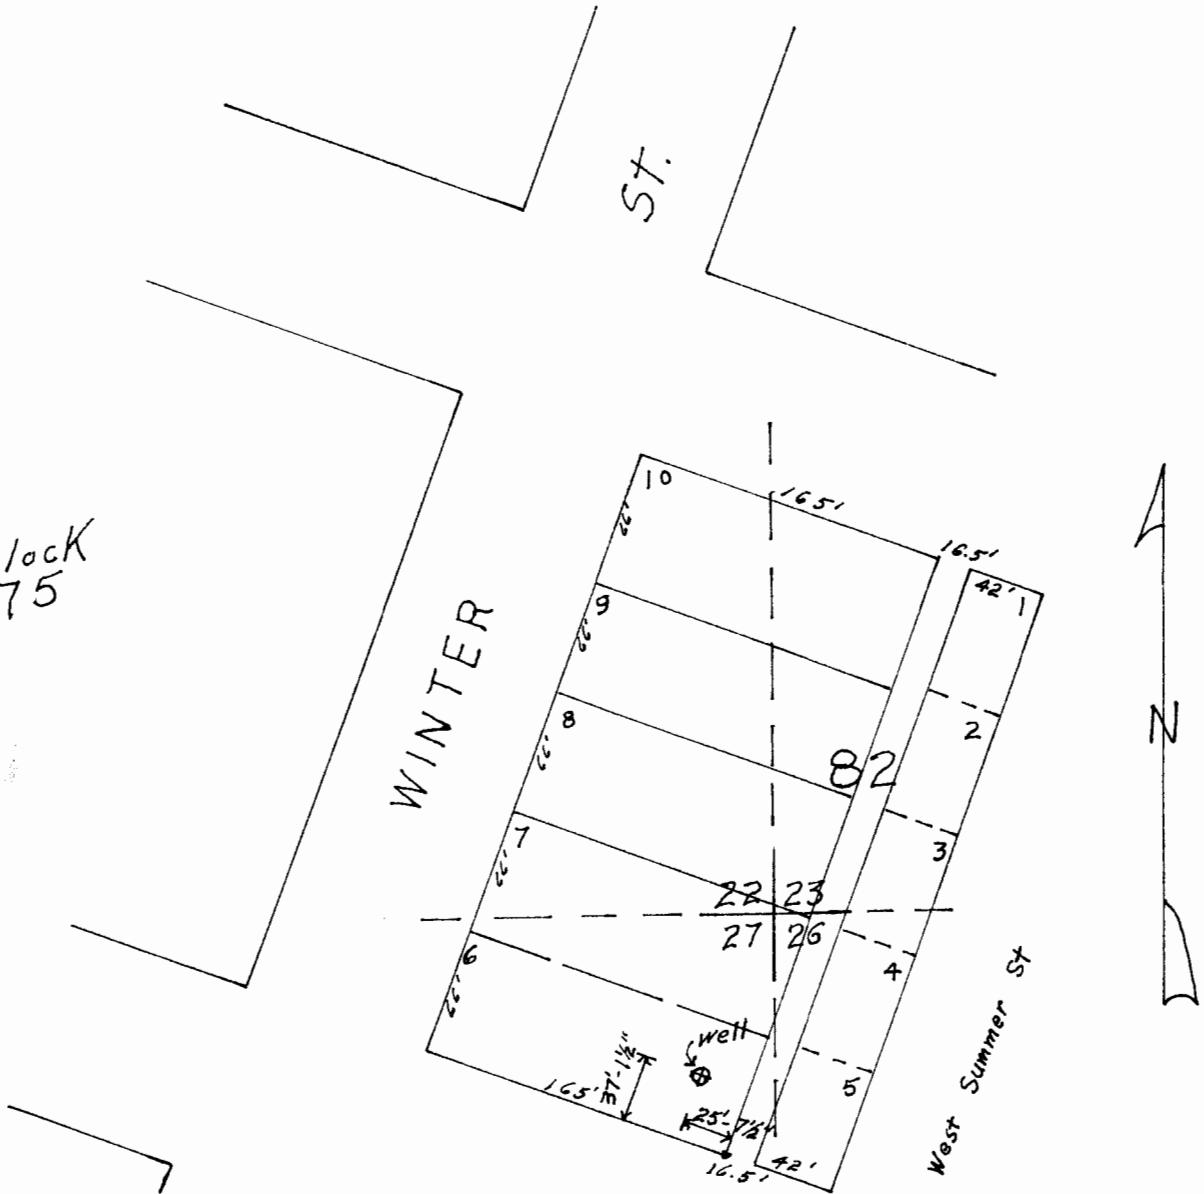

Scale 1" = 100'

Application No. G-1498
Permit No. G-1363