




FINAL PROOF SURVEY MAP

T 5 S R 1 W, W.M.
Portions of section 21 & 28

Prepared for Woodburn Nursery & Azaleas, Inc.
Tom Fessler
Application G-14763 Permit G-13640

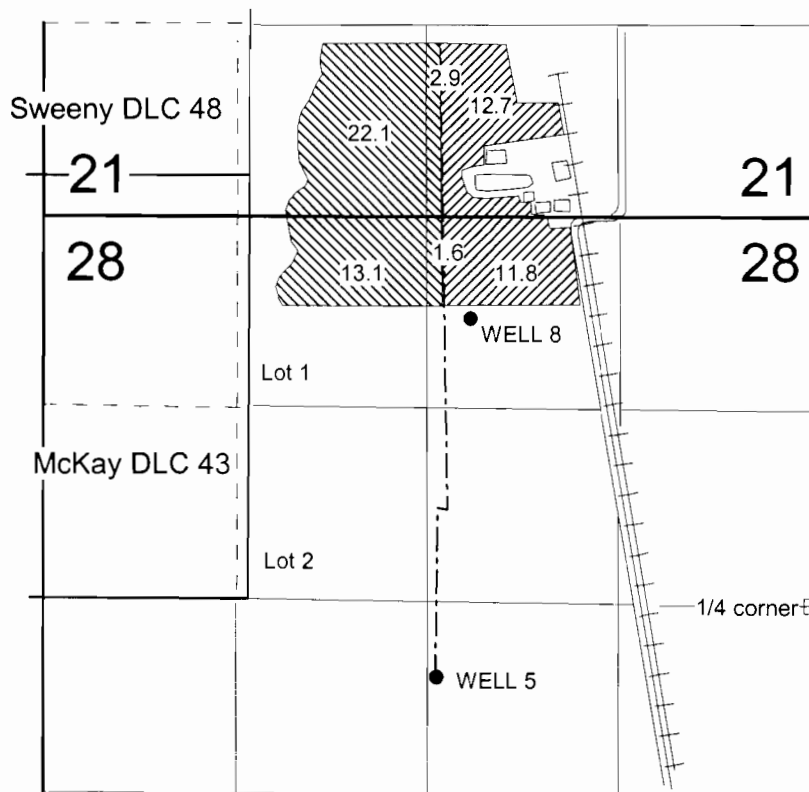

 supplemental irrigation
 nursery operations

Well 5: 500' S & 2590' W
Well 8: 1940' N & 2360' W
both from the E1/4 corner section 28

This map is for water
right purposes only.

1' = 1320'



0

2500

