


~~AUG 05 1998~~

WATER RESOURCES DEPT.
SALEM, OREGON

AUG 10 1999

WATER RESOURCES DEPT.
SALEM, OREGON

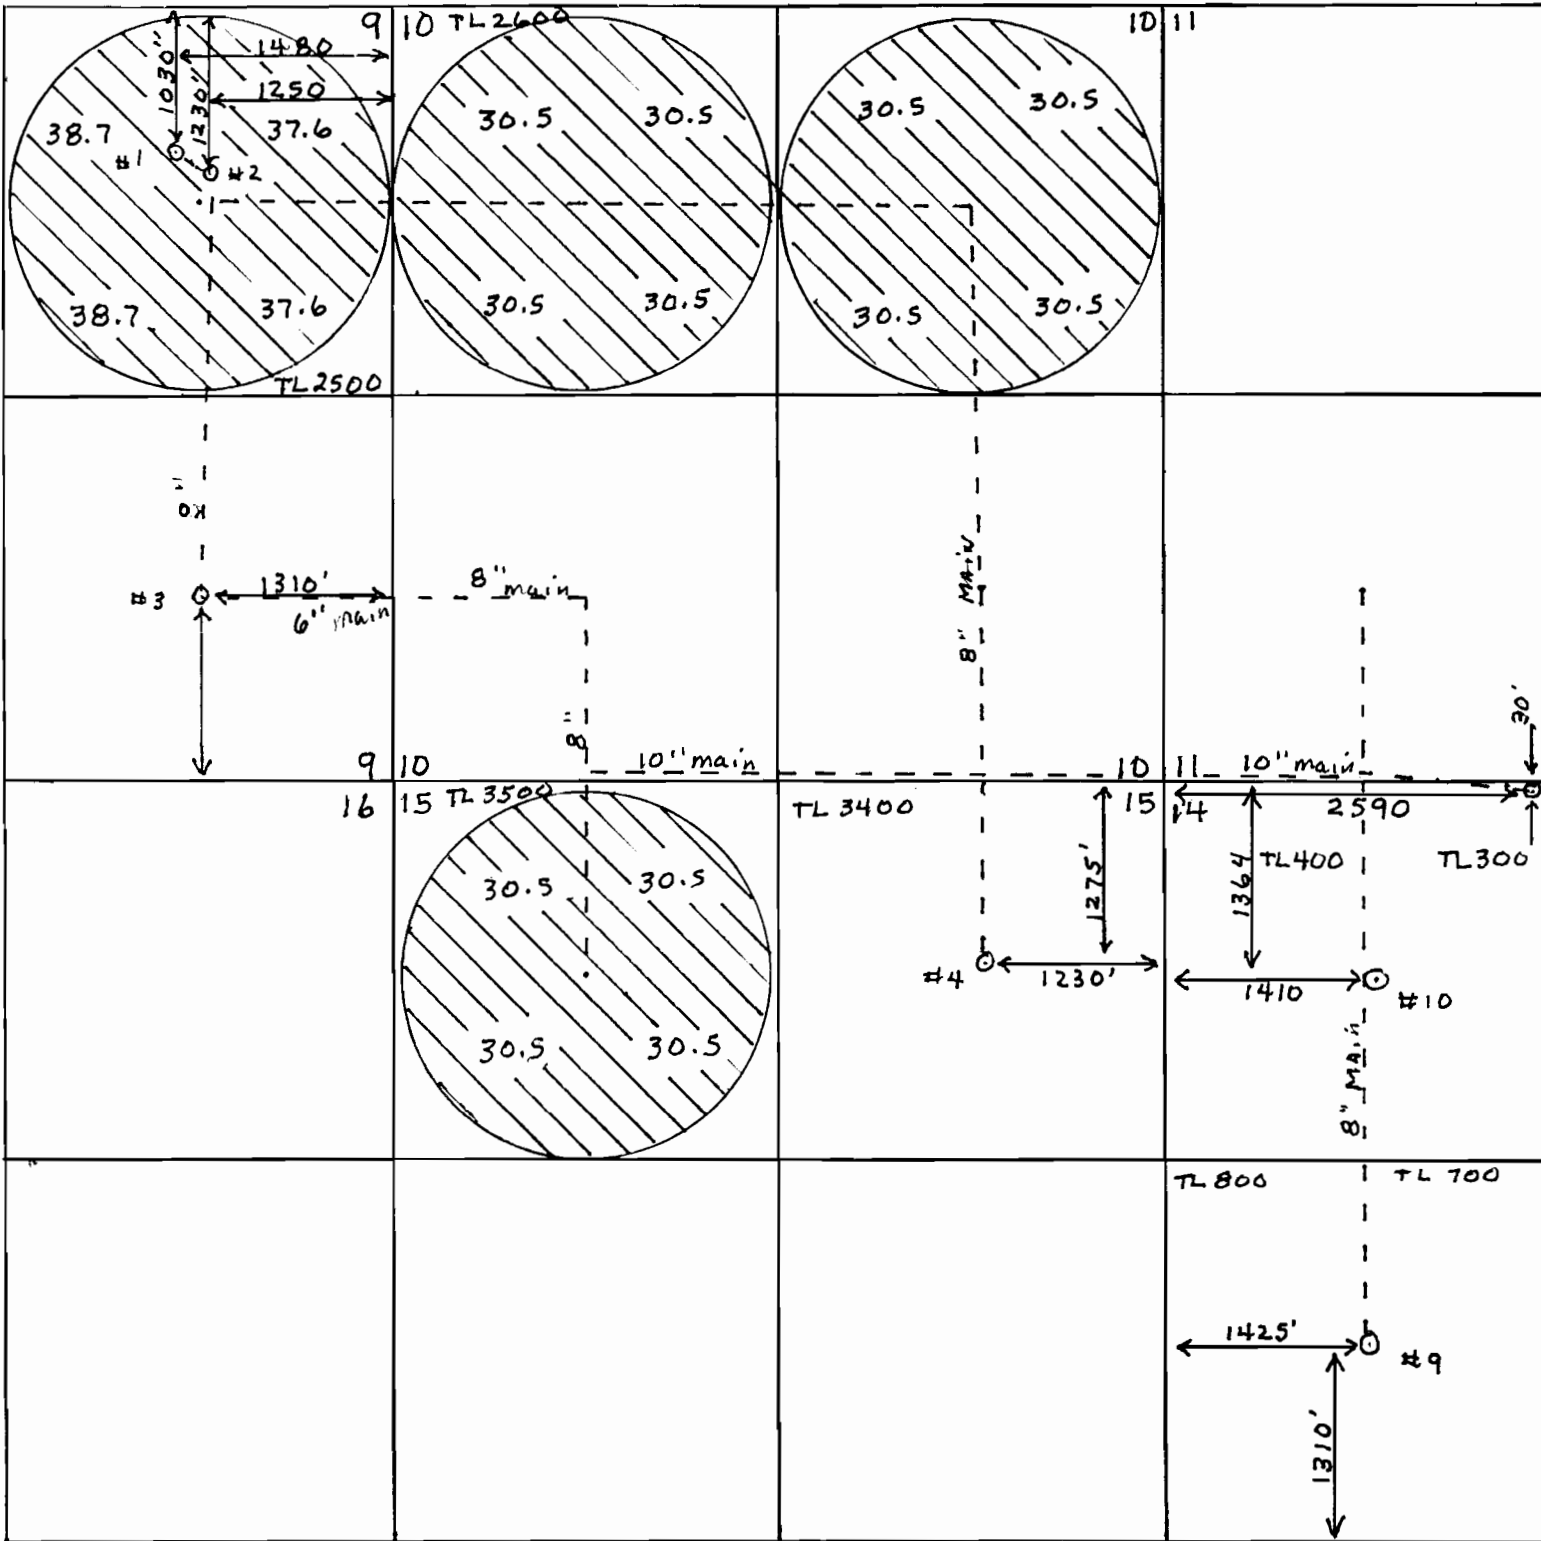

T-24-S
 R-33-E
 1" = 1320

Application No. G-14819
 Permit No.