

# FINAL PROOF SURVEY

FOR: GARY MCMANUS  
 APPLICATION G-14833, PERMIT G-13659  
 PLACE OF USE OF WATER  
 USED FOR SUPPLEMENTAL IRRIGATION AND LOCATED  
 IN SECTION 29 TOWNSHIP 40 SOUTH,  
 RANGE 19 EAST OF THE  
 WILLAMETTE MERIDIAN, LAKE COUNTY, OREGON



REVISION	BY









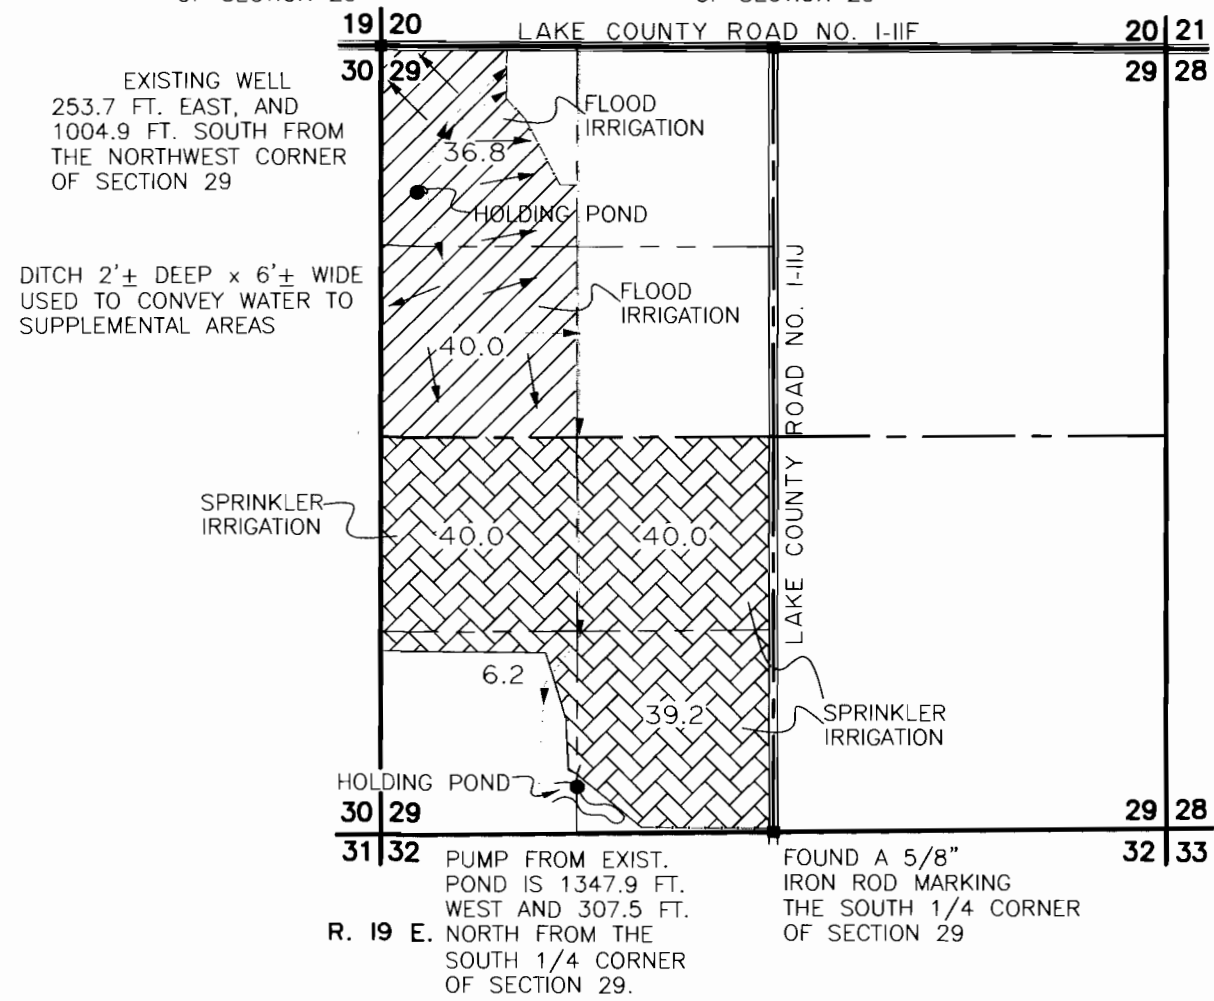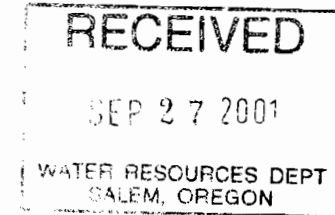



SCALE: 1"=1320'

FOUND A LAKE COUNTY  
 SURVEYOR'S BRASS CAP  
 AT THE NORTHWEST CORNER  
 OF SECTION 29

FOUND A 5/8"  
 IRON ROD MARKING  
 THE NORTH 1/4 CORNER  
 OF SECTION 29

 


## LEGEND

-  76.8 ACRES SUPPLEMENTAL WATER
-  125.4 ACRES SUPPLEMENTAL TO MAKE UP DEFICIENCY IN RATE
-  SECTION LINE
-  1/4 SECTION LINE
-  1/16 SECTION LINE
-  GOVERNMENT LOT LINES
-  EXISTING FENCE
-  EXISTING DITCH
-  EXISTING POINT OF DIVERSION OR APPROPRIATION
-  FOUND LAND SURVEY MONUMENT AS NOTED

ANDERSON ENGINEERING  
 AND SURVEYING, INC.  
 P.O. BOX 28  
 LAKEVIEW, OREGON 97630  
 (541) 947-4407  
 P.O. BOX 419  
 REDMOND, OREGON 97756  
 (541) 923-4307  
 FAX 947-2321  
 FAX 923-4308

PREPARED FOR:  
 GARY MCMANUS  
 HC 60 BOX 3310  
 LAKEVIEW, OREGON 97630

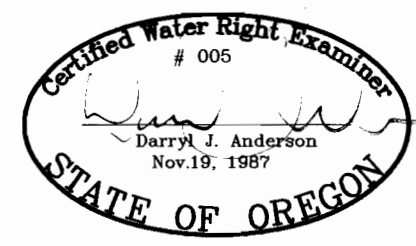

SEE ACCOMPANYING  
 SITE REPORT

NOTE: PREPARATION OF THIS MAP IS FOR IDENTIFYING PROPOSED WATER RIGHTS ONLY. IT HAS NO INTENT TO PROVIDE LOCATIONS OR DIMENSIONS OF PROPERTY BOUNDARIES.

RENEWAL 12/31/2001

DATE: 7/10/2001
SCALE: 1"=1320'
JOB: 2001_30
DWG. BY:
FILE: 2130FP
SHEET 1 OF 1