



Township 31 S

Range 15 W

Section 10

Tax Lot \*

01801

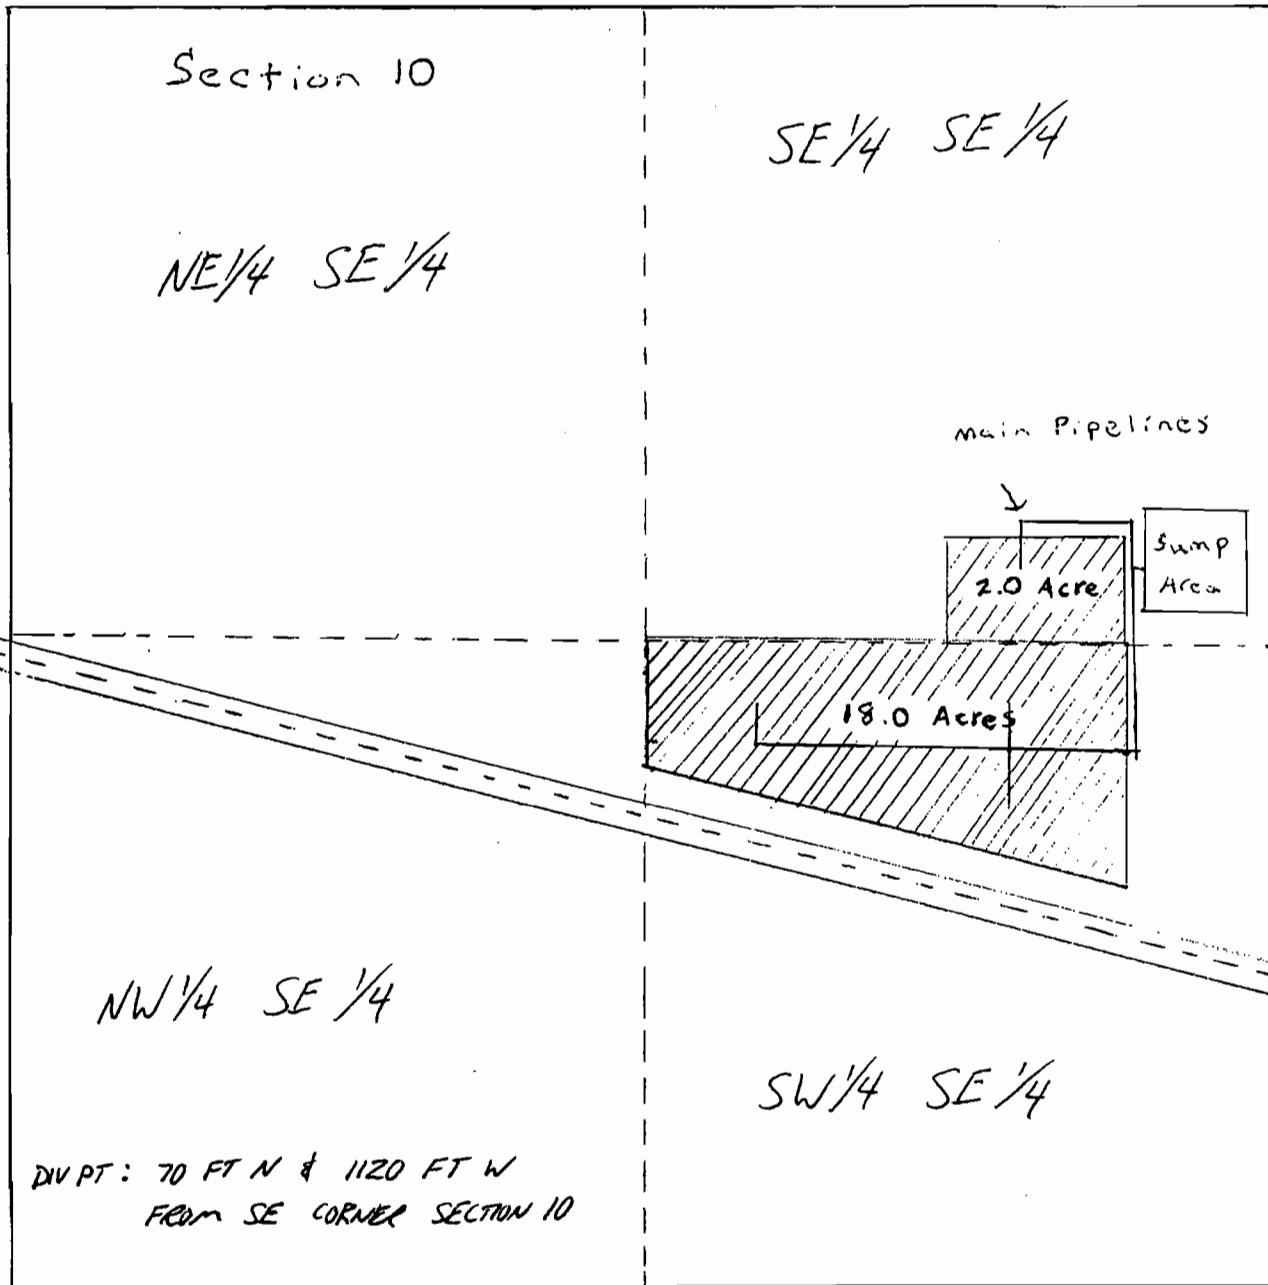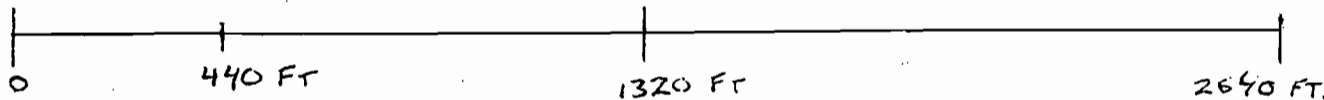

Permit No. G-136777  
Section No. 814685